

TRANSYLVANIA COUNTY HEALTH DEPARTMENT

Existing System Inspection Report

(For Building Inspection Department)

Date: December 6, 2004

Tax ID No.: 9517-60-4860-000

Receipt No.: 170438#50

Owner/Agent:

Address: Drobisch, Jack & Anne

PO Box 150 Penrose, NC 28766

Phone Number: 883-4392 (941) 302-1856 (cell)

Date System Installed: 1986? 1-6-96

Name(s) of Original Permittee:

Directions to property: 64 E. to Crab Creek; approximately 1 mile to Talley Road; 1st house past cemetery on right; 262 on mailbox (green house)

Subdivision:

Section:

Lot No.:

Inspection requested for:

- Mobile home setup
- Remodeling

- Addition
- Connection to unused system

- Business
- Other

No. of bedrooms upon connection/completion:

Current no. of Bedrooms:

Remarks: storage building - no plumbing

30' x 40'

Owner/Agent Signature:

Date: 12/4/04


At the time of the inspection there was no visible evidence of a malfunction in the system. The system is approved for proposed connections/additions/renovations or other improvements.

Signed: James A. Bayer, MS RS

Date: 12/8/04

THIS REPORT IS VALID THROUGH

3/8/04 3/8/05

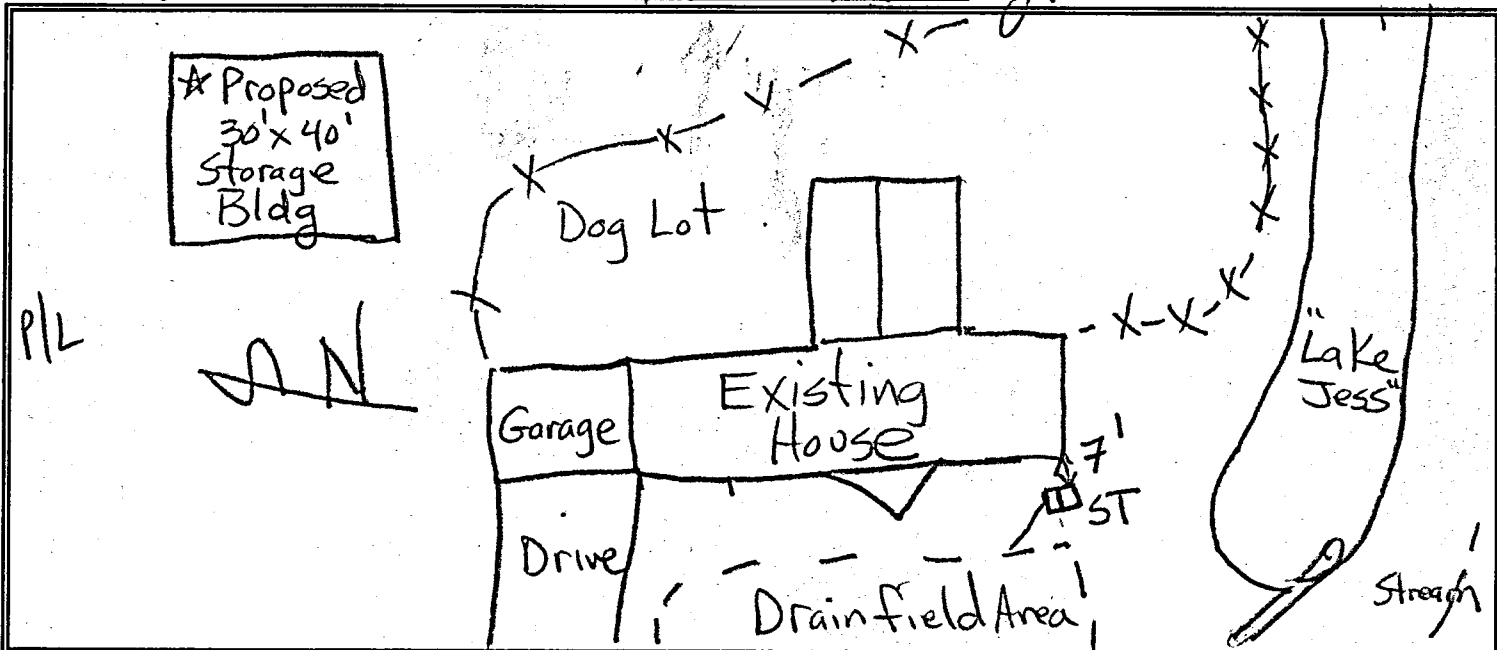



**TRANSYLVANIA COUNTY HEALTH DEPARTMENT**

(Sewage Disposal System) Improvements Permit and Certificate of Completion Sewage Treatment and Disposal Rules (ARTICLE 11 OF CHAPTER 130A OF THE GENERAL STATUTES OF NORTH CAROLINA)

**APPLICATION FOR AN IMPROVEMENTS PERMIT:**


Owner Jesse Ashe Address 194 Hendersonville, N.C.  
 Location of Property: Pearose - Little River Rd - Tolley Rd - Old Right First Cemetery  
 Plat of Property: YES  NO   
 Type of Facility: House  Mobile Home  Business   
 Estimated Sewage Flow: 360 Gallons per day  
 Type of Water Supply: Drilled Well  Spring  Other   
 Signature of Owner or Authorized Agent: Jesse Ashe Date: 10-29-85

**IMPROVEMENTS PERMIT AND CERTIFICATE OF COMPLETION**


OWNER-OCCUPANT SAME  
 LOCATION "  
 SUBDIVISION \_\_\_\_\_  
 LOT NO. \_\_\_\_\_ SECT. OR BLOCK NO. \_\_\_\_\_  
 BUILDING CONTRACTOR \_\_\_\_\_  
 ADDRESS \_\_\_\_\_  
 SEPTIC TANK CONTRACTOR Pisgah Farm & Truck  
 ADDRESS \_\_\_\_\_

HOUSE  MOBILE HOME  BUSINESS   
 NO. BEDROOMS 3 NO. BATHROOMS 2  
 SIZE OF SEPTIC TANK 1000 GALS. (Liquid) \_\_\_\_\_  
 MATERIAL: PRE-CAST  BLOCK  FIBERGLASS   
 DISTRIBUTION BOX YES  NO   
 NO. OF LINES 3 WIDTH 3" FT. LENGTH 70 FT.  
 PERCOLATION TEST YES  NO   
 WATER SUPPLY: INDIVIDUAL  PUBLIC   
 SITE CLASSIFICATION: SUITABLE   
 PROV. SUITABLE   
 UNSUITABLE

IMPROVEMENTS PERMIT: DATE: 10-29-85  
 BY: [Signature]  
 CERTIFICATE OF COMPLETION: DATE: 10/85  
 BY: [Signature]

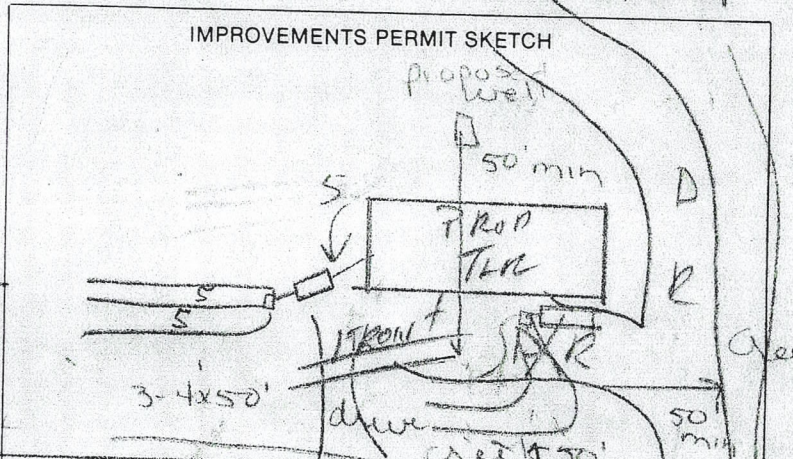

← TOLLEY RD TO ETOWAH rd  
 relayed 12/2/85

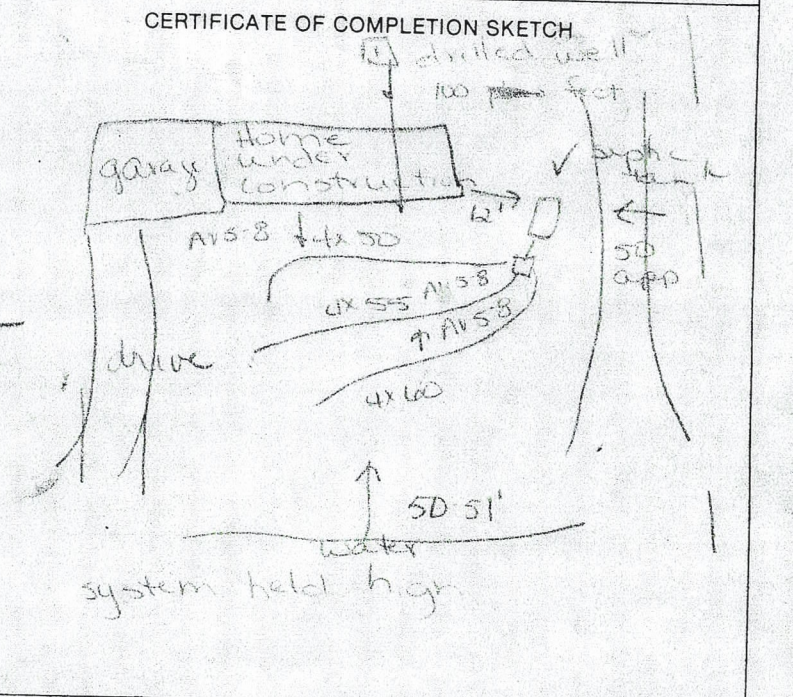

NOTICE: System installed according to Rules and Regulations but not a guarantee that it will function satisfactorily for any given period of time.

COLOR CODE: White - Owner; Pink - Improvements Permit; Blue - Contractor; Yellow - Inspection Dept.; Green - Health Dept.