

- New
- Repair
- Addition

APPLICATION # 010069

**Rutherford-Polk-McDowell District Health Department  
Operation Permit**


(Permit subject to revocation if site plans or intended use change)

Owner or Legal Agent: WAY, ANNE & PETER County: Polk  
 No. of Trenches: 3 Trench Length: 120'; 100'; 100' Trench Width: 3'  
 Type of system: III polystyrene aggregate System installed by: Curtis Pace  
 Conditions/Comments: SCM 1000 STB 862 w/Filter

Owner or Legal Agent:

Pump out old tank + abandon properly.

\* NOT DRAWN TO SCALE \* \*SITE PLAN WITH SYSTEM DETAILS\*

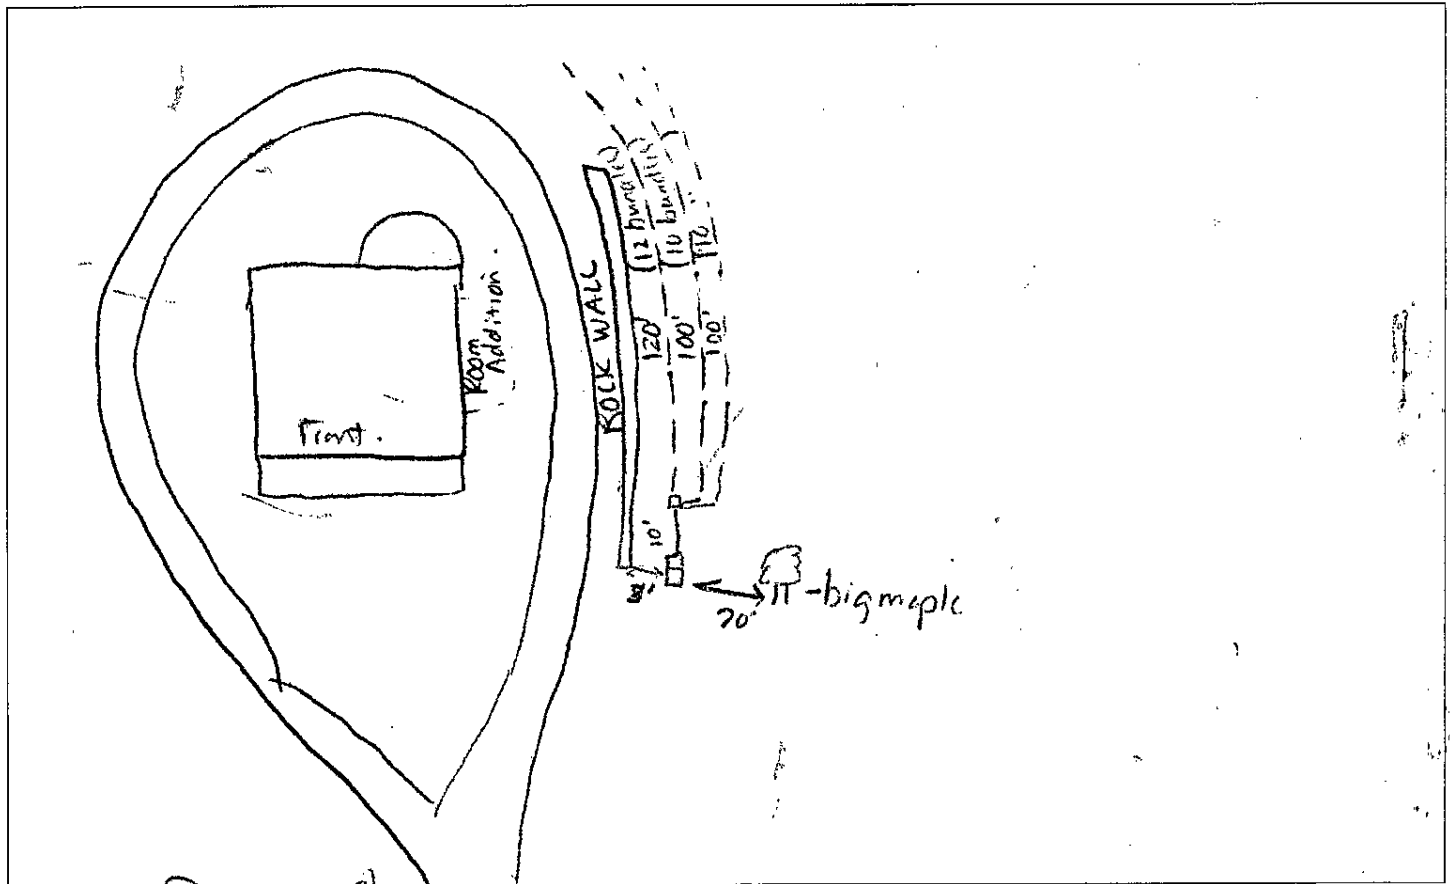

WAY, ANNE & PETER

Issued By: Dhron Shepherd Date: 04-09-01

Environmental Health Specialist

**COMPLETION OF THIS OPERATION PERMIT ALLOWS THE SYSTEM TO BE PLACED INTO USE - PROPER CARE OF YOUR SEPTIC SYSTEM REQUIRES MANAGEMENT AS WELL AS PERIODIC MAINTENANCE.**

**OPERATION AND MAINTENANCE RECOMMENDATIONS**

- (1) The drainfield does not have unlimited capacity. Try to limit the volume of your wastewater and repair any dripping faucets or toilets. Be sure that the water from the roof gutters, foundation drains, and ground surface does not flow over the system.
- (2) Do not add materials such as hygiene products, cigarette butts, coffee grinds, disposable diapers, cooking oils or grease to the septic tank system and restrict the use of garbage disposals.
- (3) Maintain a grass vegetative cover over the drainfield to prevent soil erosion.
- (4) Avoid driveway construction or other over the system and repair area and keep autos and heavy equipment off the system. Do not cover with fill dirt.
- (5) Don't wait until your drainfield fails to have your tank pumped, by then the drainfield may be ruined. Have solids pumped out of the tank as needed, usually every 3-5 years.

LP-699

New SYSTEM

Repair

Addition

APPLICATION # 010069

### Rutherford-Polk-McDowell District Health Department

### Improvement Permit (Expiration Date) 3/27/06

(Permit subject to revocation if site plans or intended use change)

Owner or Legal Agent: Anne & Peter Way County: Polk  
991 Louisiana Ave. Saluda, N.C. 28773

Mailing Address: \_\_\_\_\_

Street/Develop. Name/Lot # \_\_\_\_\_

Home Phone #: 749-1785 Work Phone #: 749-4411

Directions to property - State Road No. and Name: I 26 TOWARD SALUDA,  
LEFT ONTO LOUISIANA, 2/10 MILE ON LFT

Type of water supply:  Private well  Public or community water system  Spring III GRAVELLESS


Type of Facility: House 4BR Type of Wastewater System: EEE-272 LAY

Design Waste Flow: 480 G.P.D. L.T.A.R. Tank Capacity (min.) 1000 gallons

No. of Trenches 3 Trench Length 120, 100, 100 Ft. Trench Width 3 Ft Max. Trench Depth 24 In.

Conditions/Comments: ABANDON OLD TANK, INSTALL 320' + EEE-277 LAY  
DRAINTILE UP TO SHED AREA

\* NOT DRAWN TO SCALE \* \*SITE PLAN WITH SYSTEM DETAILS\* LOT SIZE SHED

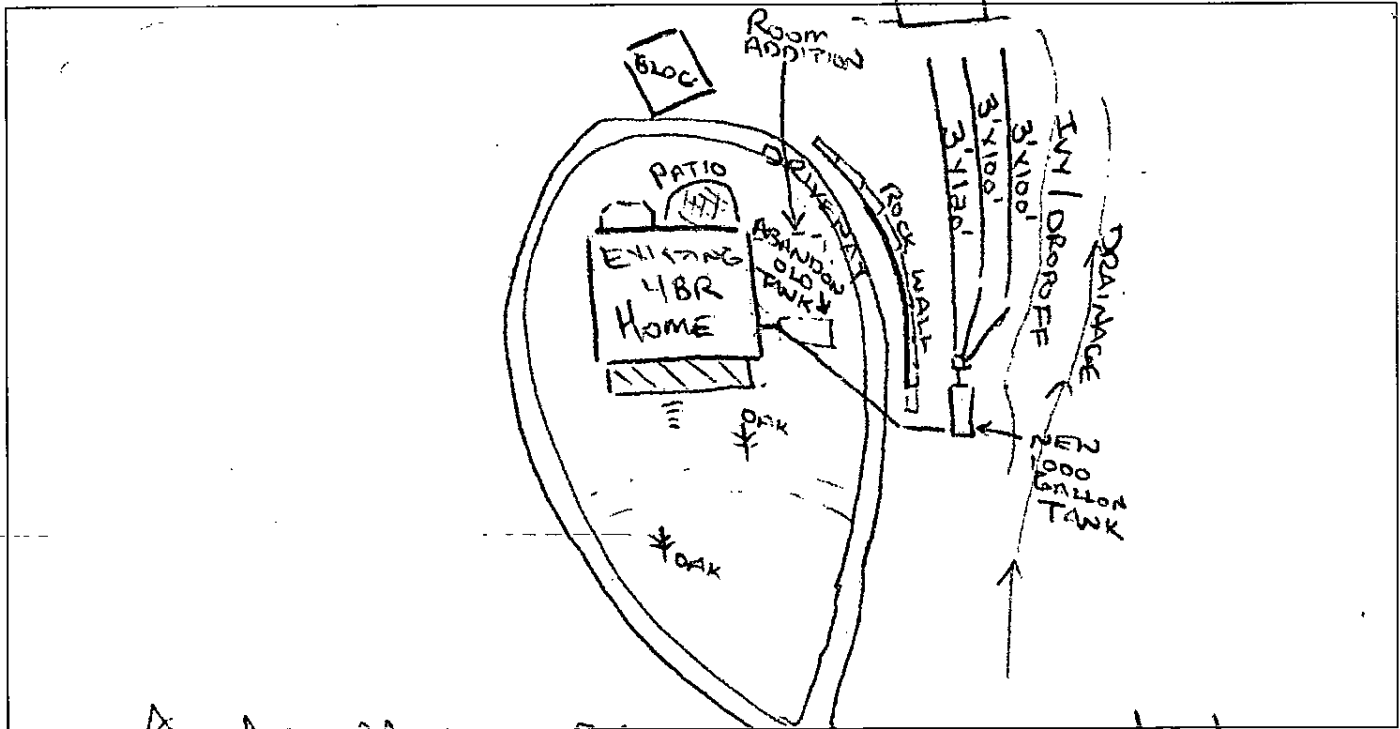

Issued By: Med E Matthews RS TO LOUISIANA Date: 3/27/01  
Environmental Health Specialist


#### AUTHORIZATION FOR WASTEWATER SYSTEM CONSTRUCTION (VOID AFTER 5 YEARS)

Construction of the wastewater system for the improvement permit indicated above is hereby authorized. The wastewater system described in the improvement permit has been designed and can be installed and operated in compliance with Article 11 of Chapter 130A of the General Statutes of N. C. and Rules adopted pursuant to this article. Any alteration of the site or soil conditions, changes to the proposed facility to be served, or submission of false information may subject the permit and authorization to suspension or revocation.

Issued By: Med E Matthews RS Date: 3/27/01  
Environmental Health Specialist

Owner or Legal Agent: WAY, ANNE & PETER



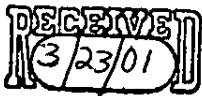

eK#  
Receipt # 47318

APPLICATION # 010069

### Rutherford-Polk-McDowell District Health Department Application for Site Evaluation

Owner/Legal Agent: Anne & Peter Way

Mailing Address: 991 Louisiana Ave Saluda NC 28773  
P.O. Box or Street City State Zip

County: Polk Home Phone #: 749-1785 Work Phone #: 749-4411

Street/Development Name/Lot # \_\_\_\_\_

Directions to property - State Road no. and Name: I-26, exit Saluda  
keep left (towards town), turn left on Louisiana  
1/2 mile from interchange; 3rd house on left

Type of Facility:  House  Mobile Home  Other: \_\_\_\_\_

Lot Size: 2.54 acres Number of Bedrooms: 3 Number of Occupants: 4

Garbage Disposal:  Yes  No Basement with plumbing:  Yes  No

Type of water supply:  Private well  Public or community water system  Spring

**BEFORE THE SITE CAN BE EVALUATED, THE FOLLOWING ITEMS MUST BE COMPLETED:**

- (1) A survey plat of the site must accompany this application showing the following drawn on it: the proposed building (decks, porches, garages included), driveway, water supply, surface waters, easements or rights of way and other pertinent features.
- (2) Property lines and house/mobile home corners must be clearly field marked on the site, with furnished ribbons.
- (3) Property must be reasonably clear of undergrowth or obstacles that prohibit a thorough site evaluation.
- (4) Please display orange Health Department sign furnished in a visible spot at roadside to aid in site location.
- (5) Site considerations may be affected by other ordinances, i.e.: flood plain or watershed, zoning, planning board restraints, restricted land use, etc., and the building inspector should be contacted prior to the health department evaluation to see if any ordinances are applicable.

The undersigned person hereby agrees that he/she has read the foregoing application and that the contents of the same are true as submitted. Any alteration of the site or soil conditions, changes to the proposed facility to be served, or submission of false information with this application may subject the improvement permit to suspension or revocation procedures. I understand that this is a formal application for a lot evaluation for a ground absorption sewage disposal system and authorize the Rutherford-Polk-McDowell District Health Department employees to go on this property for evaluation purposes. The application fee is non-refundable should the site evaluation find the site unsuitable.

Owner/Legal Agent Anne Way

Date 3/23/01