

- New
- Repair
- Addition

17 APPLICATION # 010272

**Rutherford-Polk-McDowell District Health Department
Operation Permit**

(Permit subject to revocation if site plans or intended use change)


Owner or Legal Agent: Richard, Allen County: POLK

No. of Trenches: 5 Trench Length: 400' Trench Width: 12"±

Type of system: 10" Large Diameter Pipe - SBR-2 Sph. 1250 cells System installed by: Gary Hattford

Conditions/Comments: 10" CDP - equal distribution 4" SCH to all fields.

Follow pumping procedure for plastic tank. - Sph. tank.
 * NOT DRAWN TO SCALE * * SITE PLAN WITH SYSTEM DETAILS *

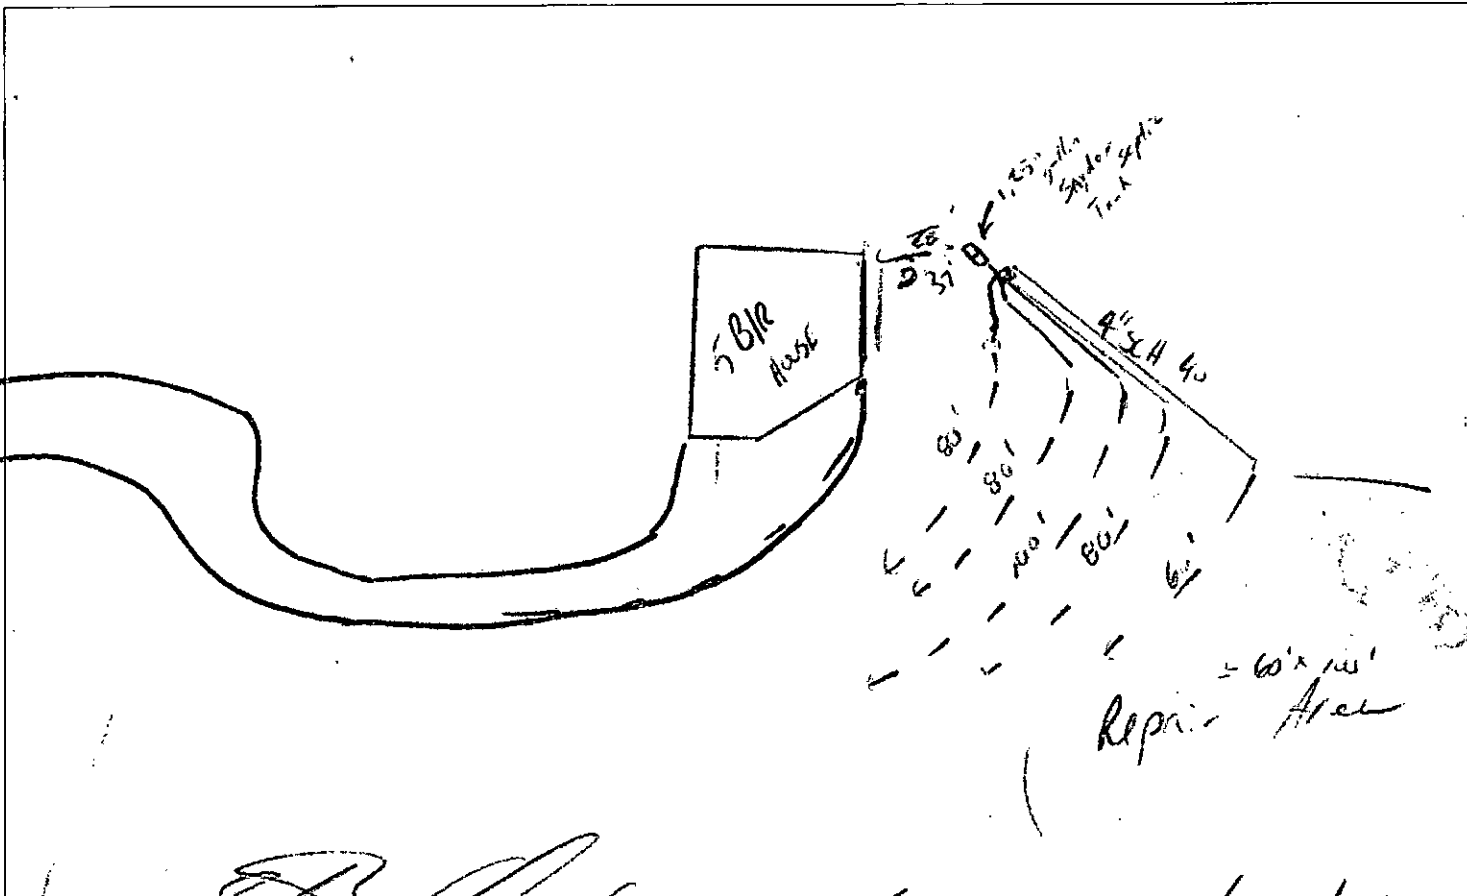

Owner or Legal Agent: **RICHARD ALLEN**

Issued By: [Signature] Environmental Health Specialist Date: 7/22/02

COMPLETION OF THIS OPERATION PERMIT ALLOWS THE SYSTEM TO BE PLACED INTO USE. PROPER CARE OF YOUR SEPTIC SYSTEM REQUIRES MANAGEMENT AS WELL AS PERIODIC MAINTENANCE.

OPERATION AND MAINTENANCE RECOMMENDATIONS

- (1) The drainfield does not have unlimited capacity. Try to limit the volume of your wastewater and repair any dripping faucets or toilets. Be sure that the water from the roof gutters, foundation drains, and ground surface does not flow over the system.
- (2) Do not add materials such as hygiene products, cigarette butts, coffee grinds, disposable diapers, cooking oils or grease to the septic tank system and restrict the use of garbage disposals.
- (3) Maintain a grass vegetative cover over the drainfield to prevent soil erosion.
- (4) Avoid driveway construction or other over the system and repair area and keep autos and heavy equipment off the system. Do not cover with fill dirt.
- (5) Don't wait until your drainfield fails to have your tank pumped, by then the drainfield may be ruined. Have solids pumped out of the tank as needed, usually every 3-5 years.

- New
- Repair
- Addition
- Re-evaluation

PIN# _____

APPLICATION # 010272

Rutherford-Polk-McDowell District Health Department

Improvement Permit (Expiration Date) 12/05/06

(Permit subject to revocation if site plans or intended use change)

Owner: Richon, Allen County: Polk

Current Mailing Address: 412 Carolina Blvd., Isle of Palms, SC 29451

(Street/Develop. Name/Lot #/SR#) Miller Mountain

Home Phone #: 843/886-8591 Work Phone #: 843/886-8775 Agent's Name & Phone #: _____

Directions to property (main rd. to site): Hwy. 108 W., TR on Howard Gap Rd., go 2.8 mi. + TR on Indian Mtn., stay straight thru rock columns into Miller Mtn., 1.1 mi. past columns, on rt.

Water Supply: Private well Public Spring Type of Wastewater System: TIS (large diameter pipe)


Type of Facility: SBR house Basement: Yes No With Plumbing: Yes No

Design Waste Flow: 600 G.P.D. L.T.A.R. 0.6 Tank Capacity (min.) 1250 gallons

No. of Trenches 5 Trench Length 80 Ft. Trench Width 1 Ft. Trench Depth 18 max. in. (on lower side wall)

Conditions/Comments: Keep system uphill. No grading allowed in drainfield area. No terracing allowed. Trenches will probably have to be hand dug.

* NOT DRAWN TO SCALE * *SITE PLAN WITH SYSTEM DETAILS* LOT SIZE/ACRES: 17 acres

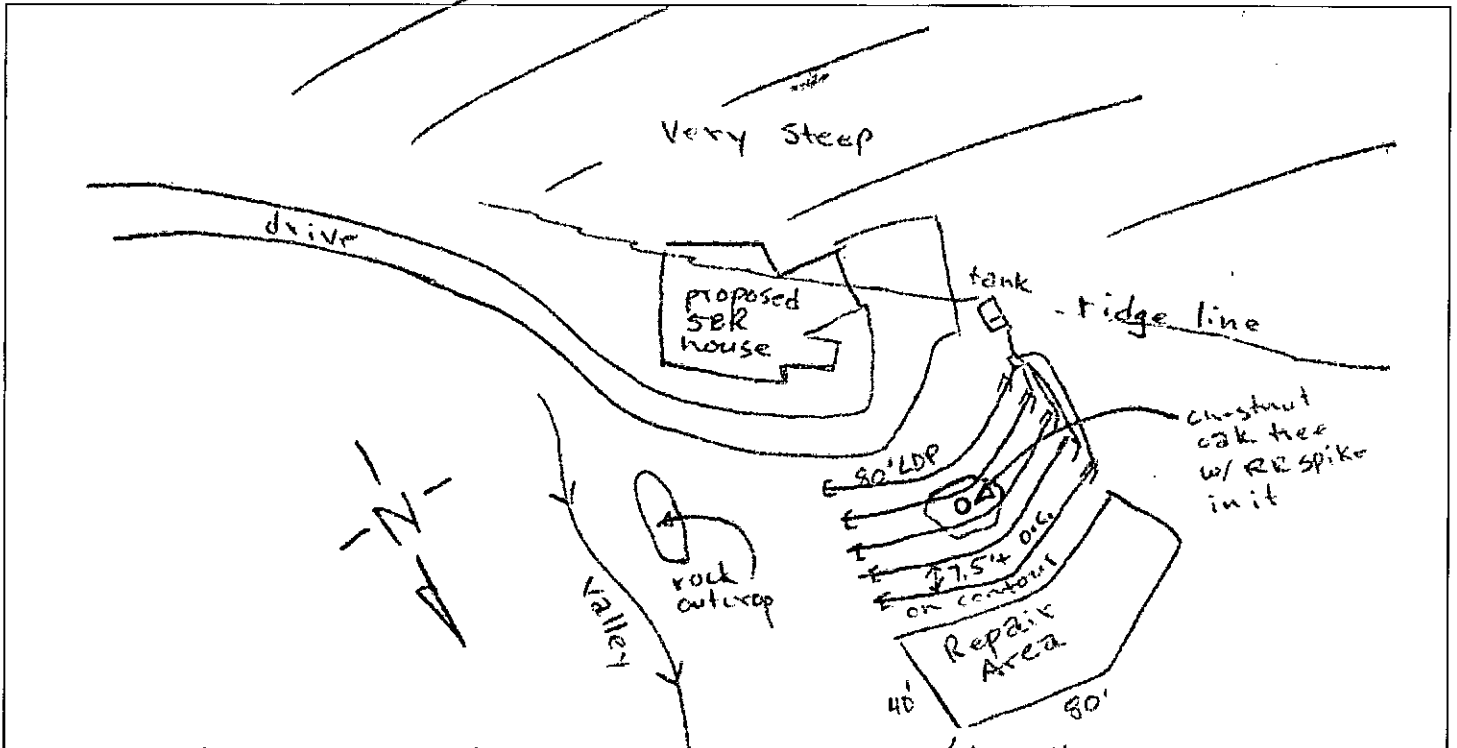

Issued By: Stuart Black
Environmental Health Specialist

Date: 12/5/01

AUTHORIZATION FOR WASTEWATER SYSTEM CONSTRUCTION
(VOID AFTER 5 YEARS)

Construction of the wastewater system for the improvement permit indicated above is hereby authorized. The wastewater system described in the improvement permit has been designed and can be installed and operated in compliance with Article 11 of Chapter 30A of the General Statutes of N.C. and Rules adopted pursuant to this article. Any alteration of the site or soil conditions, changes to the proposed facility to be served, or submission of false information may subject the permit and authorization to suspension or relocation.


Issued By: Stuart Black
Environmental Health Specialist

Date: 12/5/01

Owner: RICHMOND ALLEN

S/D & Lot #:

Scott Paue

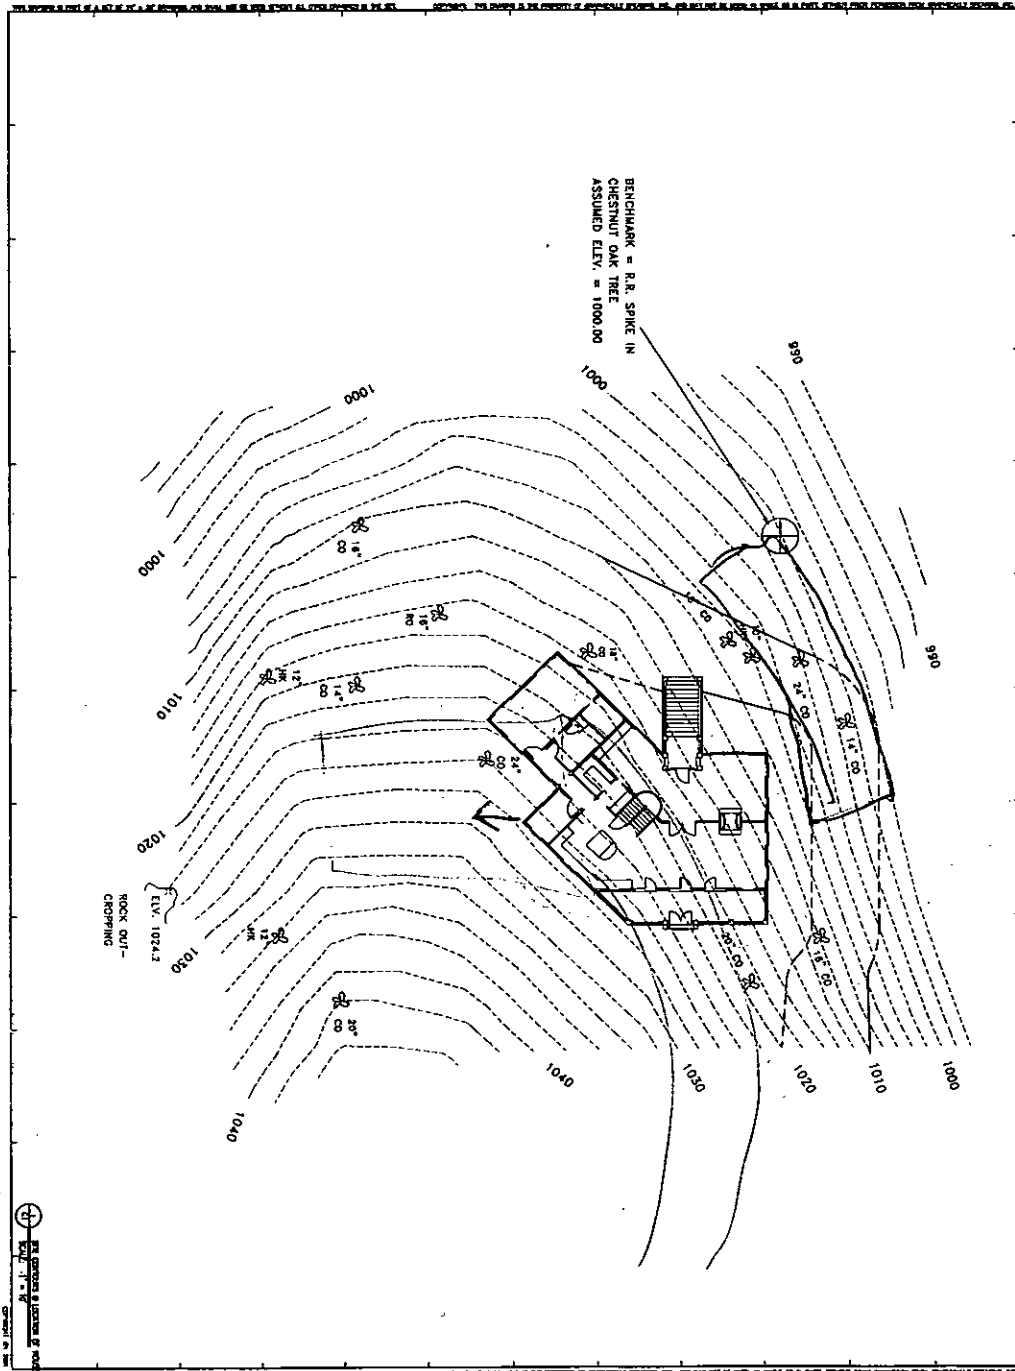


THIS DRAWING IS PART OF A SET OF 20' DRAWINGS AND SHALL NOT BE USED WITHOUT ALL OTHER DRAWINGS IN THE SET.

Copyright © 2004 by J. B. Johnson & Associates, Inc. All rights reserved. This drawing is the property of J. B. Johnson & Associates, Inc. and may not be used, in whole or in part, without their permission from J. B. Johnson & Associates, Inc.

Sheet	NO.	REVISED	BY	DATE
C1	Name	ALLEN & MERRY RICHON		
	Address	FOUR COUNTY NORTH CAROLINA		
	City	TRYON TOWNSHIP		
	State	NORTH CAROLINA		
Scale	AS SHOWN			
Drawn by	J. B. Johnson & Associates, Inc.			
Checked by	J. B. Johnson & Associates, Inc.			
Approved by	J. B. Johnson & Associates, Inc.			

010272

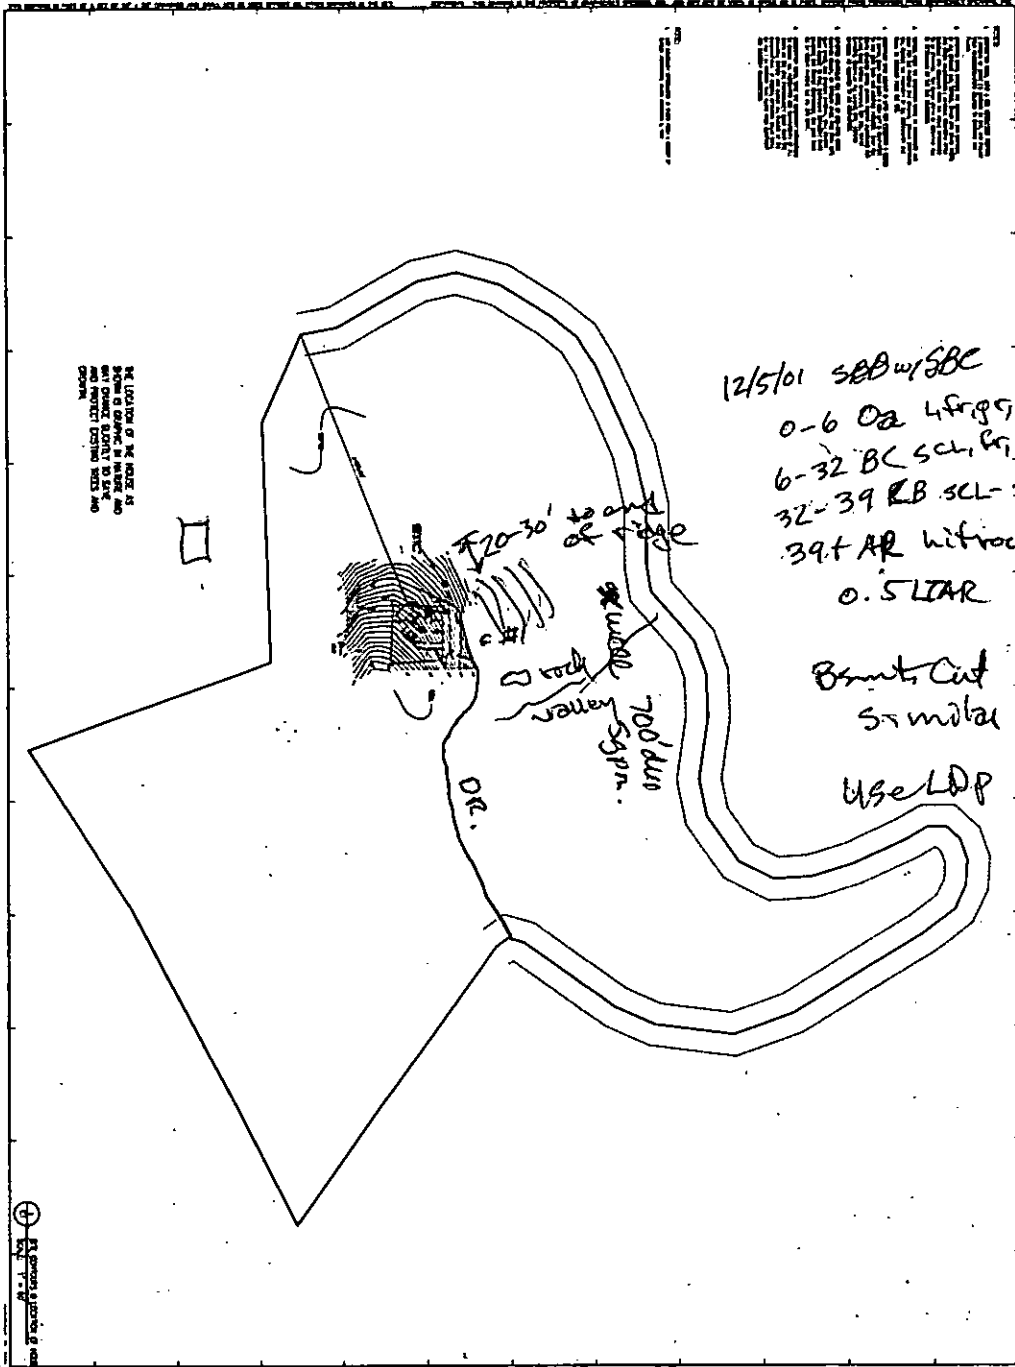

THE LOCATION OF THE HOUSE IS SHOWN AS BOLDING IN THESE AND NOT DRAWN EXPLICITLY TO BE A HOUSE BUT TO SHOW THE LOCATION AND DIRECTION.

12/5/01 SBB w/ SBC
 0-6 Oa 4fr 95SE
 6-32 BC scl. pr. sk SE
 32-39 RB scl- 54 ft 20k SE
 39+ AR w/rock
 0.5 LAR
 Brnt. Cut
 similar
 Use LDP

C1	DATE	SEP 5, 2001	CUSTOM RESIDENTIAL HOUSE PLANS FOR ALLEN & MERRY RICHON TOWNSHIP POLK COUNTY NORTH CAROLINA	G. S.	NO. REVISED 1 2 3 4 5 6 7 8 9 10	P. 1 P. 2 P. 3 P. 4 P. 5 P. 6 P. 7 P. 8 P. 9 P. 10
	DESIGNER	ALLEN & MERRY				

010272

Rec. # 45261
Check # 1011
DS 12-03-01

(Call 828-259-9955 - Brian Holan
TRAP to meet on site
APPLICATION # 010272

Rutherford-Polk-McDowell District Health Department
Application for Site Evaluation

Owner/Legal Agent: Allen Richon

Mailing Address: 412 Carolina Blvd Isle of Palms SC 29451
P.O. Box or Street City State Zip

County: Charleston Home Phone #: 843 886 8591 Work Phone #: 843 886 8775

Street/Development Name/Lot # MILLER MOUNTAIN

Directions to property - State Road no. and Name: 108 TO HOWARD GAP RD.
RT. TO INDIAN MT. (AT RT. 26) GO OVER 26 AND FOLLOW
ROAD UP THIRD DRIVE ON RIGHT 1 MILE UP

Type of Facility: House Mobile Home Other: _____

Lot Size: 17 Acres Number of Bedrooms: 5 Number of Occupants: 2

Garage Disposal: Yes No Basement with plumbing: Yes No

Type of water supply: Private well Public or community water system Spring

65.85 #6/108
58.05 #6/Indian Mound
Indian Mound/DX

BEFORE THE SITE CAN BE EVALUATED, THE FOLLOWING ITEMS MUST BE COMPLETED:

- (1) A survey plat of the site must accompany this application showing the following drawn on it: the proposed building (decks, porches, garages included), driveway, water supply, surface waters, easements or rights of way and other pertinent features.
- (2) Property lines and house/mobile home corners must be clearly field marked on the site, with furnished ribbons.
- (3) Property must be reasonably clear of undergrowth or obstacles that prohibit a thorough site evaluation.
- (4) Please display orange Health Department sign furnished in a visible spot at roadside to aid in site location.
- (5) Site considerations may be affected by other ordinances, i.e.: flood plain or watershed, zoning, planning board restraints, restricted land use, etc., and the building inspector should be contacted prior to the health department evaluation to see if any ordinances are applicable.

The undersigned person hereby agrees that he/she has read the foregoing application and that the contents of the same are true as submitted. Any alteration of the site or soil conditions, changes to the proposed facility to be served, or submission of false information with this application may subject the improvement permit to suspension or revocation procedures. I understand that this is a formal application for a lot evaluation for a ground absorption sewage disposal system and authorize the Rutherford-Polk-McDowell District Health Department employees to go on this property for evaluation purposes. The application fee is non-refundable should the site evaluation find the site unsuitable.

Owner/Legal Agent Allen B Richon Date Nov 28, 2001