

HENDERSON COUNTY DEPARTMENT OF PUBLIC HEALTH  
 IMPROVEMENTS PERMIT  AUTHORIZATION TO CONSTRUCT   
 FOR INSTALLATION INSPECTION CALL 694-6043 BETWEEN 7AM-8AM

17080101978

Permit Number

AC-34860 OP-5113 (1999 REPAIR)

Associated Permits

Owner JEREMY ABEE Date 2-28-17  
 Property Address 117 DORNE DR.  
 Development \_\_\_\_\_ Lot No. \_\_\_\_\_  
 Location: KANUGA RD. TL DORNE DRIVE  
(JUST PAST BEAUMONT EST.'S) BEAR  
LEFT TO HOUSE AT END.  
 Residence  Mobile Home \_\_\_\_\_ Business \_\_\_\_\_  
 Other \_\_\_\_\_  
 Bedrooms 3  
 No. Employees 0 Design Flow GPD 360  
 Lot Size 1.60 AC  
 Basement: Yes  No  Basement Plumbing: Yes  No   
 Water Supply: City  Individual  Shared  Community   
 Other \_\_\_\_\_ WI# PE  
 Owner's Signature \_\_\_\_\_

New Construction  Repair   
 Pre-Existing Tank  Addition   
 LTAR PRE-EXISTING EPS  
 System Classification SYSTEM  
 System Type \_\_\_\_\_  
 Linear Footage \_\_\_\_\_  
 Min. Tank Size \_\_\_\_\_  
 Drainfield \_\_\_\_\_ Sq. Ft. \_\_\_\_\_  
 Max. Trench Bottom Depth on Low Side of Trench \_\_\_\_\_

Permit valid for 5 years from date of issuance.  
 Repairs to be completed within 30 days.

*[Signature]*  
 Environmental Health Specialist


\*\*VALID ONLY FOR USE AS DESCRIBED ABOVE—DRAWING NOT TO SCALE

SYSTEM TO BE INSTALLED FIRST \_\_\_\_\_  SAPROLITE SYSTEM \_\_\_\_\_  SEE ATTACHED INSTALLATION GUIDELINES

The issuance of this permit by the Health Department in no way guarantees the issuance of other permits. The permit holder is responsible for checking with appropriate governing bodies in meeting their requirements. This site is subject to revocation if the site plan, plat, or the intended use changes. The Improvement Permit shall not be affected by a change in ownership of the site. This permit is subject to compliance with the provisions of the Laws and Rules for Sewer Treatment and Disposal and to conditions of this permit.

\* CLEAN WATER IS SURFACING ABOVE 2<sup>ND</sup> TRENCH.

- (1) INSPECT ALL FIXTURES FOR LEAKS & REPAIR IF NECESSARY.
- (2) UNCOVER EXIST CROSS-OVER PIPE & CONFIRM THAT THE BOTTOM OF THE PIPE IS EVEN WITH OR HIGHER THAN THE TOP OF EPS MATERIAL (LEAVE OPEN FOR INSPECTION).
- (3) PACK CLAY TIGHTLY AROUND CROSS-OVER PIPES AFTER INSPECTION.
- (4) REPLACE OUTLET TEE IN TANK ~~IF NEEDED.~~

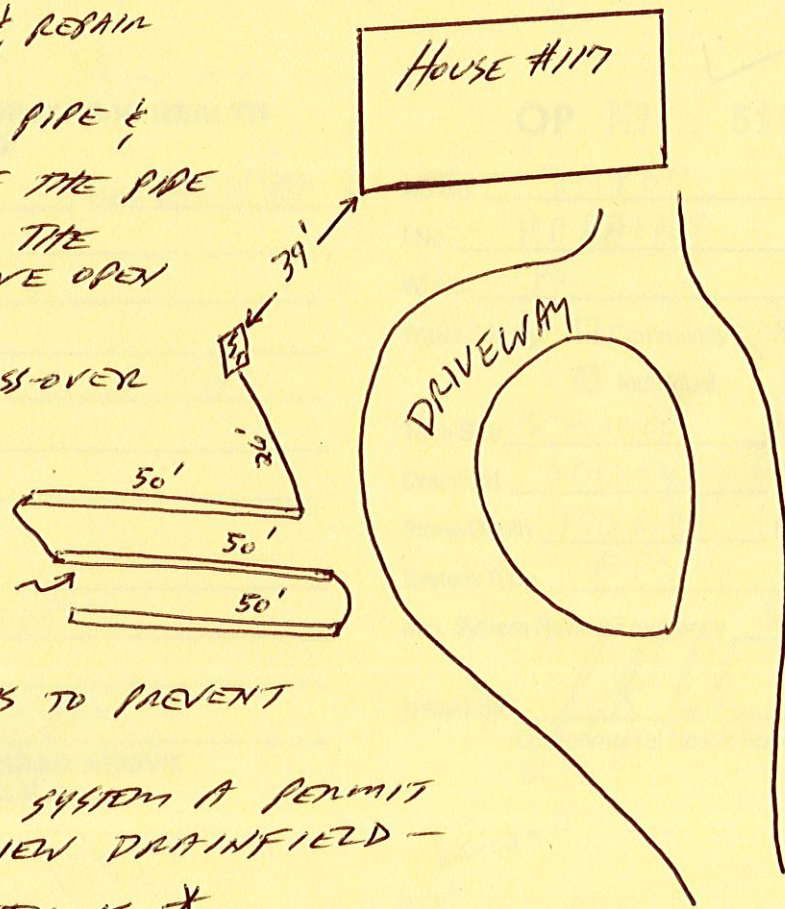

- (5) WASH CLOTHES ON ALTERNATING DAYS TO PREVENT FLOODING DRAINFIELD.
  - (6) IF THIS DOES NOT REPAIR SYSTEM A PERMIT WILL BE ISSUED FOR A NEW DRAINFIELD -
- \* PLEASE CALL IF QUESTIONS \*
- \* SEE ATTACHED COPY OF 1999 REPAIR PERMIT \*



**HENDERSON COUNTY DEPARTMENT OF PUBLIC HEALTH  
OPERATIONS PERMIT**

OP No. 5113 ✓

Owner Diane McClung Date 6 Oct 99

Building Contractor 3000 Kanuga Rd.

Septic Tank Installer B. Simpson

Lot No. \_\_\_\_\_ Development \_\_\_\_\_

Location Kanuga T/L Dorae Drive T/L  
1st drive - house at end

House  Mobile Home

Other \_\_\_\_\_

No. Bedrooms 3 Design Flow GPD 360

Lot Size 1.6 Ac.

Installer \_\_\_\_\_  
Owner's Signature Bill Summit

AC No. 34860

I No. REPAIRS

WI No. PE

Water Supply:  Community  Shared

Individual  City

Tank Size 5cm 1000 Gal.

Drainfield 600 equiv Sq. Ft.

Stone-Depth 150 EPS Inches

System Type EPS

Min. System Review Frequency 5 yrs

Issued By: J.R. Roberts R.S.  
Environmental Health Specialist

**VALID ONLY FOR USE AS DESCRIBED ABOVE  
DRAWING NOT TO SCALE**

