

File Name: Falls Creek

TRANSLYVANIA COUNTY HEALTH DEPARTMENT 8595-63-
ON-SITE WASTEWATER DISPOSAL APPLICATION/PERMIT 3989-000

Tax ID T412G01007

System Code: 1

Receipt No 5286 #75

Agent/Owner: Chamberlain, Richard

Mailing Address: 220 Waldsi Court Brevard, NC 28712

Home Phone #: () 862-5447

Work Phone #: () _____

Proposed Buyer: _____

Mailing Address: _____

Home Phone #: () _____

Work Phone #: () _____

Property Location: Falls Creek Road Subdivision: Falls Creek Phase/Sec.: _____ Lot #: 12
Road/Street

Directions to property: Wilson Road to Williamson Creek Road - Knob Road - to Falls Creek Road - make right before Whispering Springs - one property off corner of Whispering Springs and Knob Road. on right hand side.

Flood Zone	
Is the property in a flood zone?	
<input type="checkbox"/> Yes	<input checked="" type="checkbox"/> No <input type="checkbox"/> Unknown
Inspections	
Flood Zone	
<input type="checkbox"/> Yes	<input type="checkbox"/> No
<input type="checkbox"/> Approved	<input type="checkbox"/> Disapproved
Initials _____	Date _____

Installation for: Mobile Home Single Double House No. Bedrooms: 3 Basement: Yes No With Plumbing: Yes No Ind./Commercial Other

If Indust./Commercial/Other: Number of employees: _____ Operation: (Describe) _____

Lot size: .624 ac Date lot recorded: 1987 Right of ways, easements, etc. no Water Supply: Private: Spring Well Shared Supply Public/Community

I certify the above to be correct to the best of my knowledge. Permission is hereby granted to perform a soil evaluation on the property described above. If the information submitted in this application is falsified or changed, the permit shall become void.

Applicant/Agent Signature: Richard T. Chamberlain Date: 1-17-96

Construction Authorization Issue Date: 3-28-96 Construction Authorization Renewed Date: _____

IMPROVEMENTS PERMIT
(Diagram and Conditions Attached)

New Installation: Repair/Addition: Original Permittee: _____ Dated: _____

Design waste flow: 360 GPD LTAR: .45 Septic Tank Capacity: 900 gal./min. Pump Tank Capacity: _____ gal./min. Proposed Wastewater System: CONV.

Drainfield: Total Trench Length: 270' Square Footage: 810 (Equivalency?) Individual Trench Length: see drawing Maximum Trench Depth (Low Side): 18" Trench Width: 36"

Distribution Method: Serial feed System distance to nearest well: _____ Water line: _____ Foundation: 5' Property line: 10' Vertical Cut: _____

Comments & Special Conditions: _____

This improvements permit is issued by the Transylvania County Health Department and is issued without expiration. This permit must be accompanied by an "Authorization for Wastewater System Construction" prior to the installation or repair of the wastewater system or before any required building permits can be issued. Any alterations or modifications (man made or natural) to the site, system design, or conditions in which the permit was issued will cause the permit to be void.

I agree to install the wastewater disposal system in accordance with the improvement permit and any conditions specified therein.





Signed: Richard T. Chamberlain Date: 3-29-96 Final Inspection by: Jim Ralston RS Date: 5.6.96

Permit Prepared by: Jim Ralston RS Date: 3-28-96 Installed by: Bobby Smathers Date: 5.6.96


PERMIT AND CONSTRUCTION AUTHORIZATION MUST BE ON SITE DURING ALL PHASES OF CONSTRUCTION/INSTALLATION AND INSPECTION

* Applicant requests using IWW S 95-3R (HDS 2012 HORZ) as drainfield. Richard T. Chamberlain

gravel around
4" PE tubing

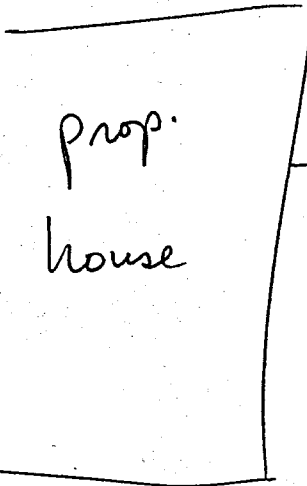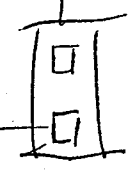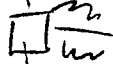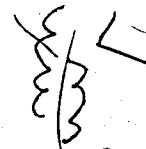

Prop.
house

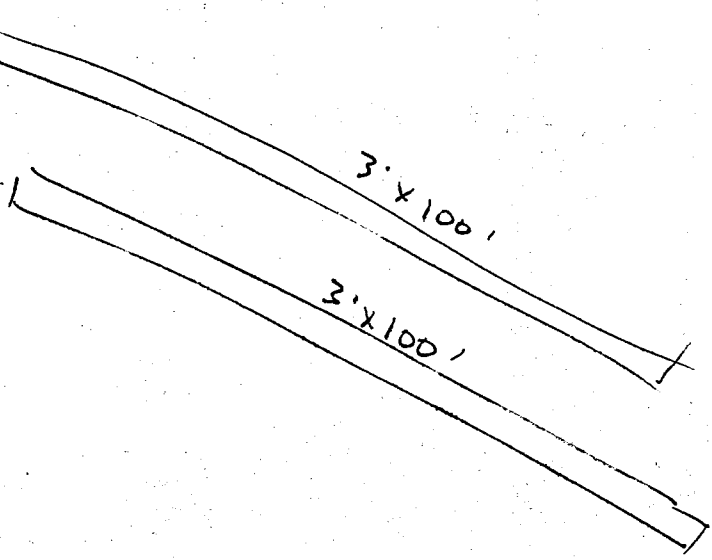

TRANSYLVANIA COUNTY HEALTH DEPARTMENT IMPROVEMENT PERMIT DIAGRAM

Date: 3.28.96

Tax ID No: T 412 601007

Owner/ Agent: Richard Chamberlain

Receipt No: 5286


Address: See permit

Phone No: 862 5447

Location of Property: " "

Subdivision: Falls Creek Lot No: 12 Section: Plat of Property:

All parts of the septic tank system shall be located at least 100', or the maximum feasible distance from any well, but in no case less than 50 feet.

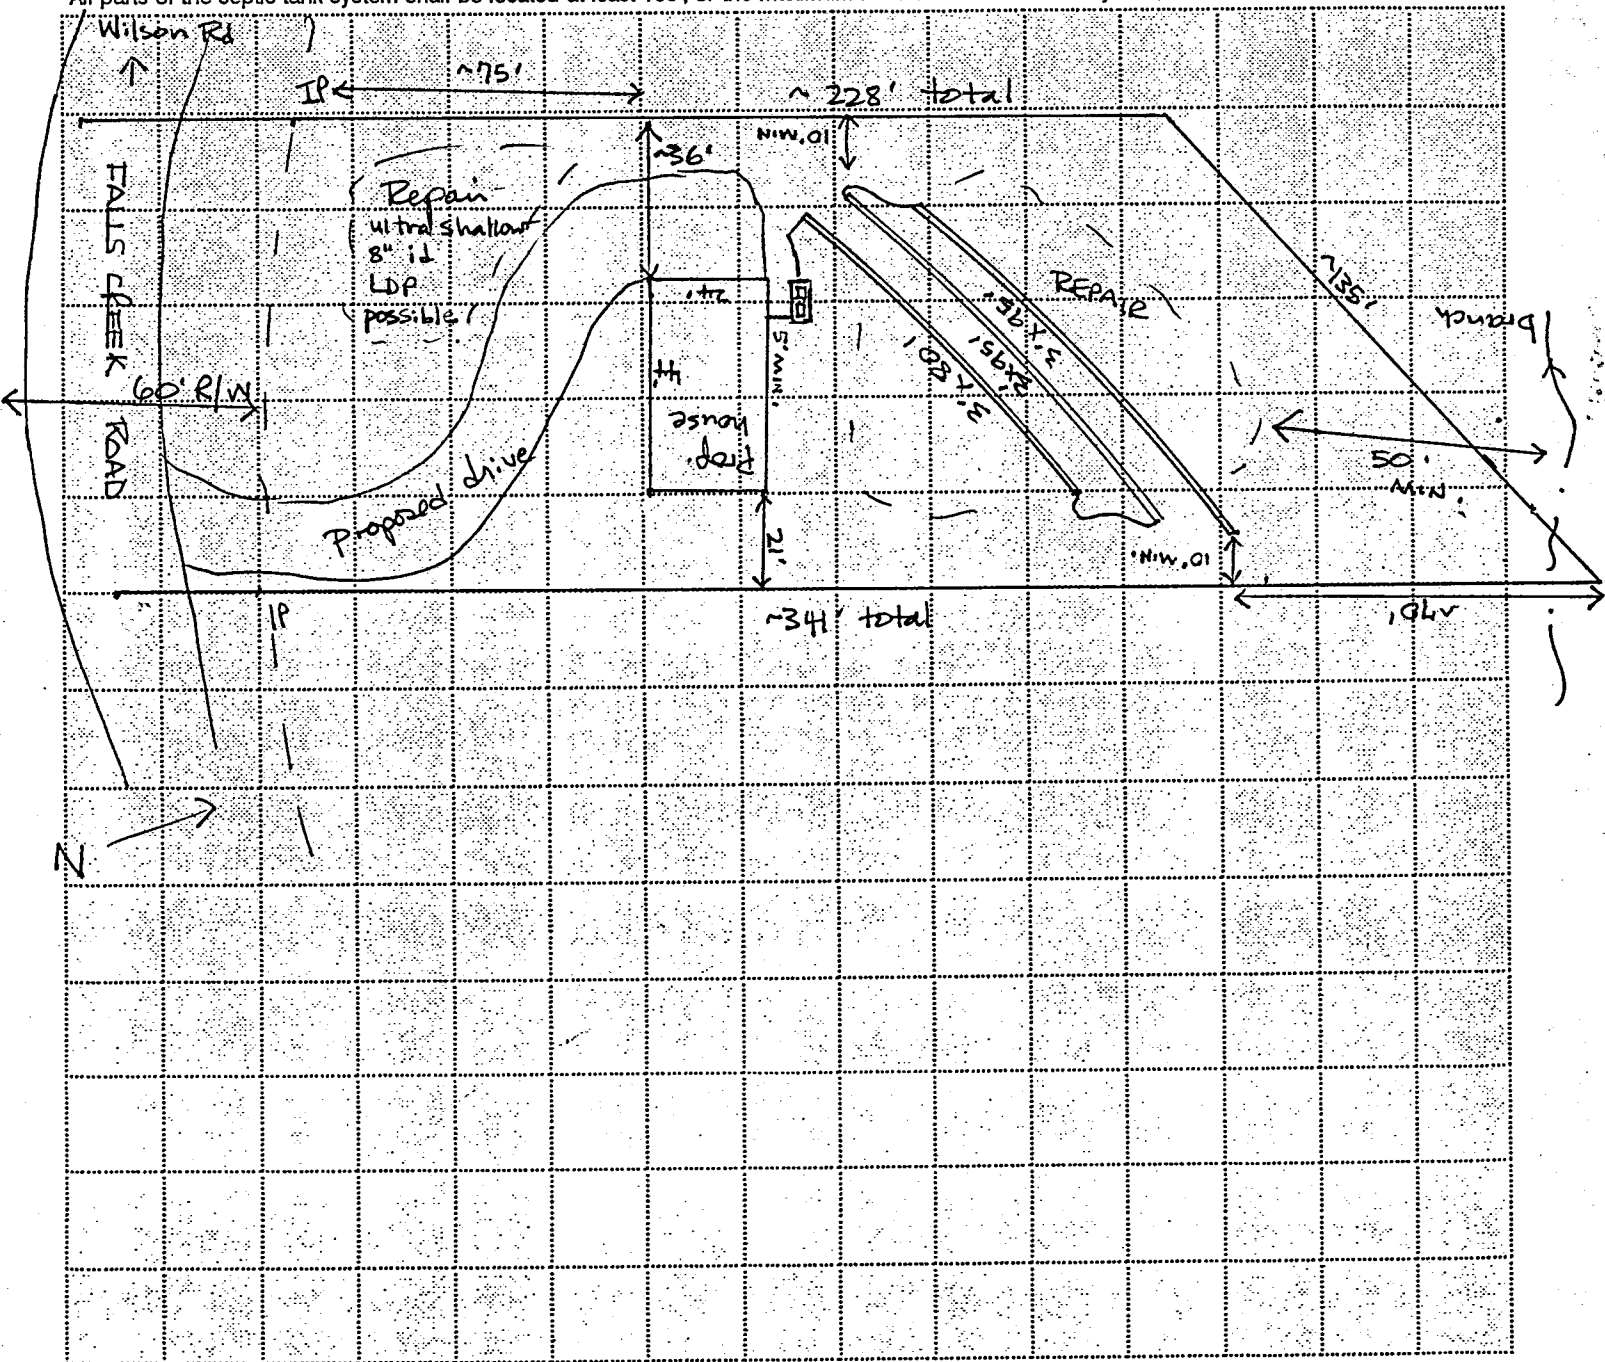

Minimum distance between trenches shall be 9 feet, on center.

Scale 1" : 40 feet

Keep trenches level, on contour, and shallow (maximum depth 18" on the low side of trench). Trench width is 36 inches.