

18-052 9-1-22



TRANSYLVANIA COUNTY DEPARTMENT OF PUBLIC HEALTH
WELL PERMIT OR WELL REPAIR PERMIT.
CERTIFICATE OF COMPLETION

New Well Repair To Existing Well

WP21-110 9506-46-4411-000 Tritt, Chad
Permit No. Parcel I.D. Issued To
221
TBD Gladiola Drive Thomas Woods, Lot 208-A
Property Street Address Subdivision /Sec/Lot#

Well Grouting Inspection

Casing Type PVC Casing Thickness/Weight SDR-21 Casing Depth 35'
Diameter 6.25" Grout Type Concrete Grout Depth 20'
Grout Method Pour

Inspected By: M. C. Coffey, REHS Date: 11/22/22

Well Head Inspection

Inches Above Grade 12" Air Vent Threadless Sample Tap ONLY
Sanitary Seal (if hose bib) Anti-Siphon Present N/A Well Plate
Pump Plate Well Depth 305' Static Water Level 60' Yield 15

Contractor Merrill
Certification # 3004
Date 11/23/22 Depth 200'
Horsepower 3/4HP

F+W 10GPM
240V

Inspected By: James a Bayer, REHS Date: 5/11/23

Well Report Received (GW-1a) Dustin Merrill
Well Contractor Merrill Well Certification # 3004


Issued By James a Bayer, REHS Date 5/12/23

~~REVIS~~

TRANSYLVANIA COUNTY DEPARTMENT OF PUBLIC HEALTH ~~WELL~~ PERMIT DIAGRAM

File Name: Tritt, Chad Well Permit No.: WP21-110 PIN: 9506-46-4411-000

THOMAS WOODS, LOT 209A
GLADYOLA DRIVE

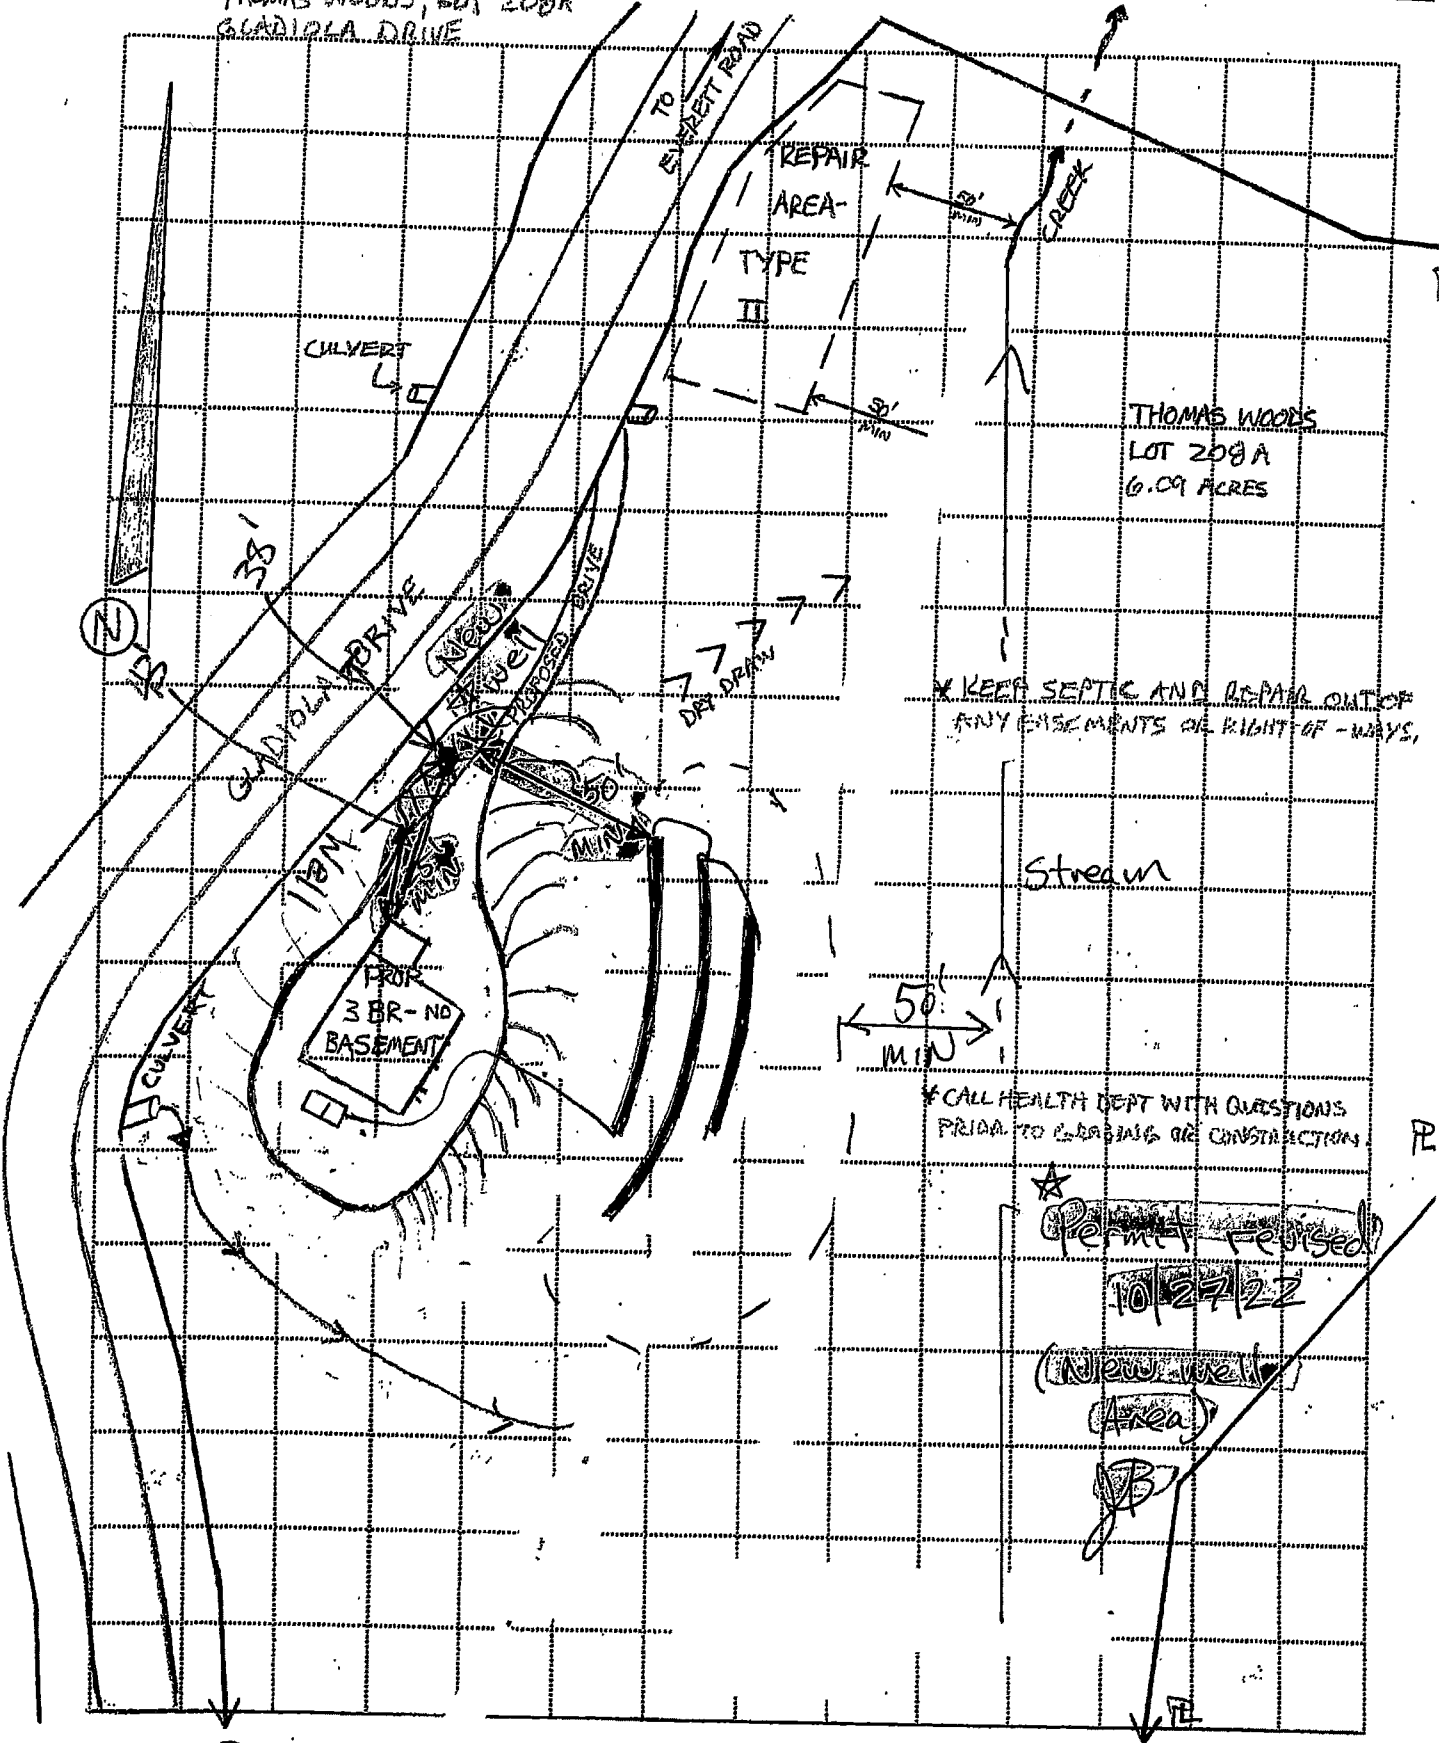

* KEEP SEPTIC AND REPAIR OUT OF ANY EASEMENTS OR RIGHT-OF-WAYS.

* CALL HEALTH DEPT WITH QUESTIONS PRIOR TO GRABALS OR CONSTRUCTION

~~Permit Revised~~

10/27/22

(New well Area)

JB

SCALE: 1" = _____