



Public Health
Protect. Promote. Prevent.

Henderson County Department of Public Health

Steven E. Smith, MPA, Health Director | Seth Swift, R.H.E.S., Environmental Health Supervisor

1200 Spartanburg Highway, Suite 100, Hendersonville, NC 28792
Main Phone: (828) 694-6060 | Administration FAX: (828) 697-4523

Septic and/or Well Permit Search Request

CONTACT INFORMATION:

Date of Request: 9/2/21
Name: Mercy Langer Phone #: 828 230-4578
FAX #: _____ EMAIL: mercy.langer@gmail.com

PROPERTY INFORMATION

Address (REQUIRED) 60 Ives Farm Lane Hendersonville, NC 28792

Subdivision: _____ Lot# _____

List Current and All Previous Owners of Property (If the ownership records do not go back as far as the date the house was built, we may have difficulty finding a record. Please make sure to include as much information as possible):

Timothy Langer

Previous Road Name(s): _____

Year Residence was Built: 2004 PIN: 953886770

Please submit your completed request to:

Fax # 828-697-4523

Email: HCDPH_EnvHealth@hendersoncountync.gov

ENVIRONMENTAL HEALTH DEPARTMENT SEARCH RESULTS:

Search Completed by: HL Date: 9-3-21

- Record Located Copy Attached
- No Record Located
- Incomplete property information provided unable to process

Telephone
828-692-4228

Henderson County Department of Public Health
1347 SPARTANBURG HIGHWAY
HENDERSONVILLE, NORTH CAROLINA 28792

04120177387

I _____
WI _____

WELL CERTIFICATE OF COMPLETION

Stored in future

PERMIT WC No. 4410

Owner or Builder Tim Laufer

Mailing Address of Applicant _____ Phone _____


Pin No. 00953882671855 Subdivision/Park _____ Lot # _____

Location 64 W. TIL Cummins Rd. TIR Big Willow TIL Ives Farm Lane

Take Every Left to End

Type Drilled Size 8 1/4" Depth 180 Casing Depth 7.3

Grout Concrete Yield 40 GPM Contractor/Driller Barker

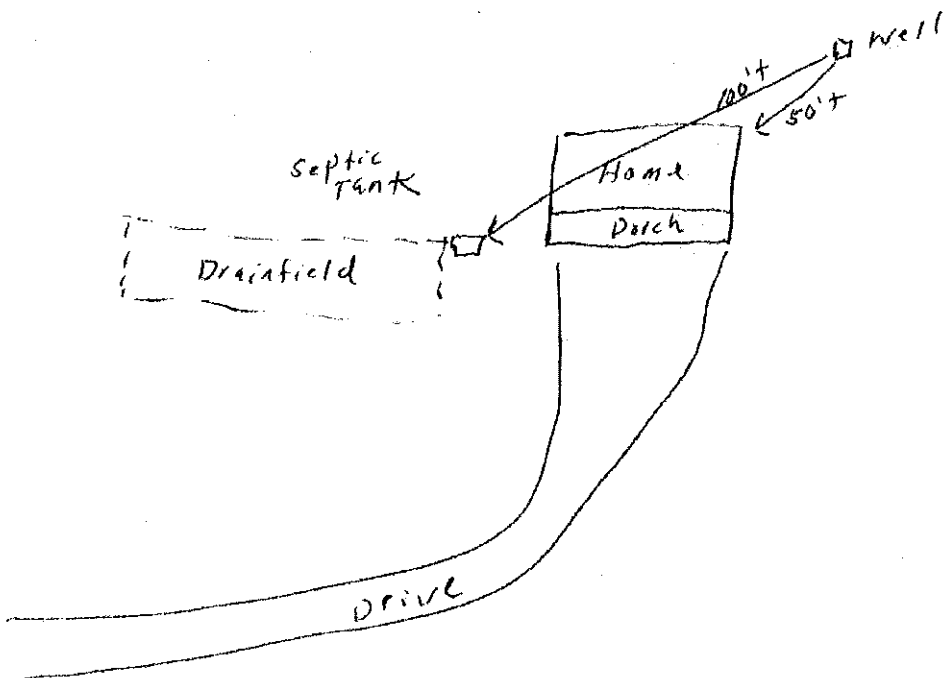

Date Issued 6-18-04 Environmental Health Specialist [Signature]

Permit Received By _____

**HENDERSON COUNTY DEPARTMENT OF PUBLIC HEALTH
OPERATIONS PERMIT**

04120177387
OP 8888

Owner TIM LAUFFER 674-6870 Date 6-14-04
 Building Contractor BOB HUGGINS
 Septic Tank Installer BOB HUGGINS
 Lot No. _____ Development _____
 Location 64W TL CUMMINGS TO END
TR BIG WILLOW 1ST LEFT IVES FARM
LANE BEAR LEFT AT ALL FORKS UNTIL
 House Mobile Home YOU GET TO SITE
 Other AT END -
 No. Bedrooms 3 Design Flow GPD 360
 Lot Size 14.65 ± ACRES
 Owner's Signature [Signature]

AC No. 39218
 I No. 39218
 WI No. 7003
 Water Supply: Community Shared
 Individual City
 Tank Size 5CM-1000 Gal. FILTER
 Drainfield 900 Sq. Ft.
 Stone Depth 12 Inches
 System Type CONVENTIONAL
 Min. System Review Frequency N/A
 Issued By: [Signature]
 Environmental Health Specialist

**VALID ONLY FOR USE AS DESCRIBED ABOVE
DRAWING NOT TO SCALE**

6-14-04 Final - DC

Jan 6, 2003 - INSPECTION INSTALLATION
CA

