



Henderson County Department of Public Health

Steven E. Smith, MPA, Health Director | Seth Swift, R.H.E.S., Environmental Health Supervisor

1200 Spartanburg Highway, Suite 100, Hendersonville, NC 28792
Main Phone: (828) 694-6060 | Administration FAX: (828) 697-4523

Public Health
Prevent. Promote. Protect.

Septic and/or Well Permit Search Request

Please submit your completed request to Fax # 828-697-4523 or to email address:
HCEnvHlth@hendersoncountync.org

PROPERTY INFORMATION

Subdivision: Blue Ridge Estates Lot# Lot 2 Block B Section 3

Current Address: 93 Foster Hill Drive, Hendersonville, NC 28739

List Current and All Previous Owners of Property: ✓ 2017 ✓ STEGE, JESSICA R.; STEGE, SEAN - current owners

Carol J. Guzewicz and William P. Guzewicz 2001

Carol J. Beracha (1995-1997)

J R Bresko and wife, Etal (1975)

Previous Road Name(s): none

Year Residence was Built: 1977 PIN: 9556841976

YOUR CONTACT INFORMATION:

0.81 AC.

Date of Request: 09/13/2019

Name: Jennie Beckwith Phone #: _____

FAX #: _____ EMAIL: jbeckwith@kw.com

*Blue Church Road
Foster Hill
(2 left)*

ENVIRONMENTAL HEALTH DEPARTMENT SEARCH RESULTS:

Search Completed by: EX Date: 9/20/19

Record Located Copy Attached

No Record Located

Incomplete property information provided unable to process

*These Ops was found on-line
@ GIS Henderson County -
Go to Go Maps - put in address +
look under the
permit tab. Click on the
repair permits + then click on
Repair Permit @ the bottom +
then click
on the OP @ the bottom.*

*Please verify
information*

HENDERSON COUNTY DEPARTMENT OF PUBLIC HEALTH
OPERATIONS PERMIT

Owner Bill + Carol Guzewicz Date 3-25-11
Property Address 93 Foster Hill Drive
Septic Tank Installer Owner Cert # _____
Lot No. _____ Development # FE 2 Blk B Blue Ridge WI-
Est #
House Mobile Home
Other _____
No. Bedrooms 3 Design Flow PE.
No. Employees _____ Lot Size _____


Installer's Signature [Signature]
Installation: [Signature] Date: 3-25-11
Final Issued By: [Signature]

Project # 10010108952
Permit Number _____
AC-10080108953
Associated Permits _____

System Classification PE.
System Type _____
Quantity/Linear Footage ↓
Tank Size SCM-1200
Drainfield _____ Sq.Ft. _____
Min. System Review Frequency _____

Saprolite yes no

VALID ONLY FOR USE AS DESCRIBED ABOVE
DRAWING NOT TO SCALE

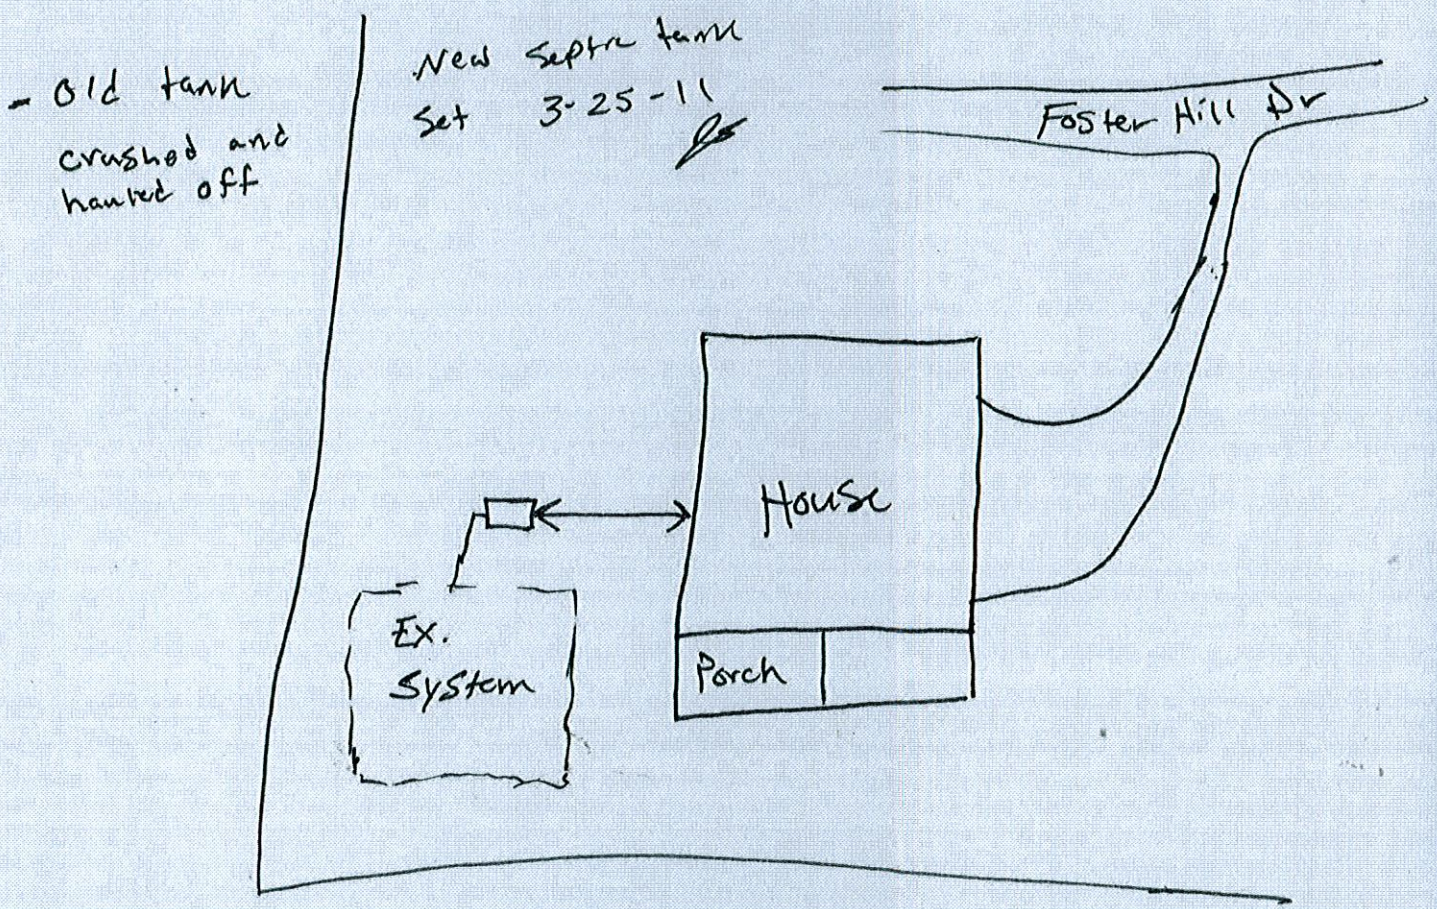

HENDERSON COUNTY DEPARTMENT OF PUBLIC HEALTH
OPERATIONS PERMIT

Owner Carol Guzenicz Date 6/11/08
 Property Address 93 Foster Hill Dr
 Septic Tank Installer Larry Rhodes
 Lot No. _____ Development Blue Ridge Estates
 House Mobile Home
 Other _____
 No. Bedrooms 3 Design Flow PE
 No. Employees _____

Installer's Signature _____
 Installation: [Signature] Date: 6/6/08
 Final Issued By: [Signature]

VALID ONLY FOR USE AS DESCRIBED ABOVE
DRAWING NOT TO SCALE

07080110261
Permit Number


Associated Permits

WI- _____
 Tank Size Marin 1000 Gal.
 Drainfield _____ Sq.Ft.

System Type EPS

Min. System Review Frequency _____

System Classification III-g
 Quantity/Linear Footage _____

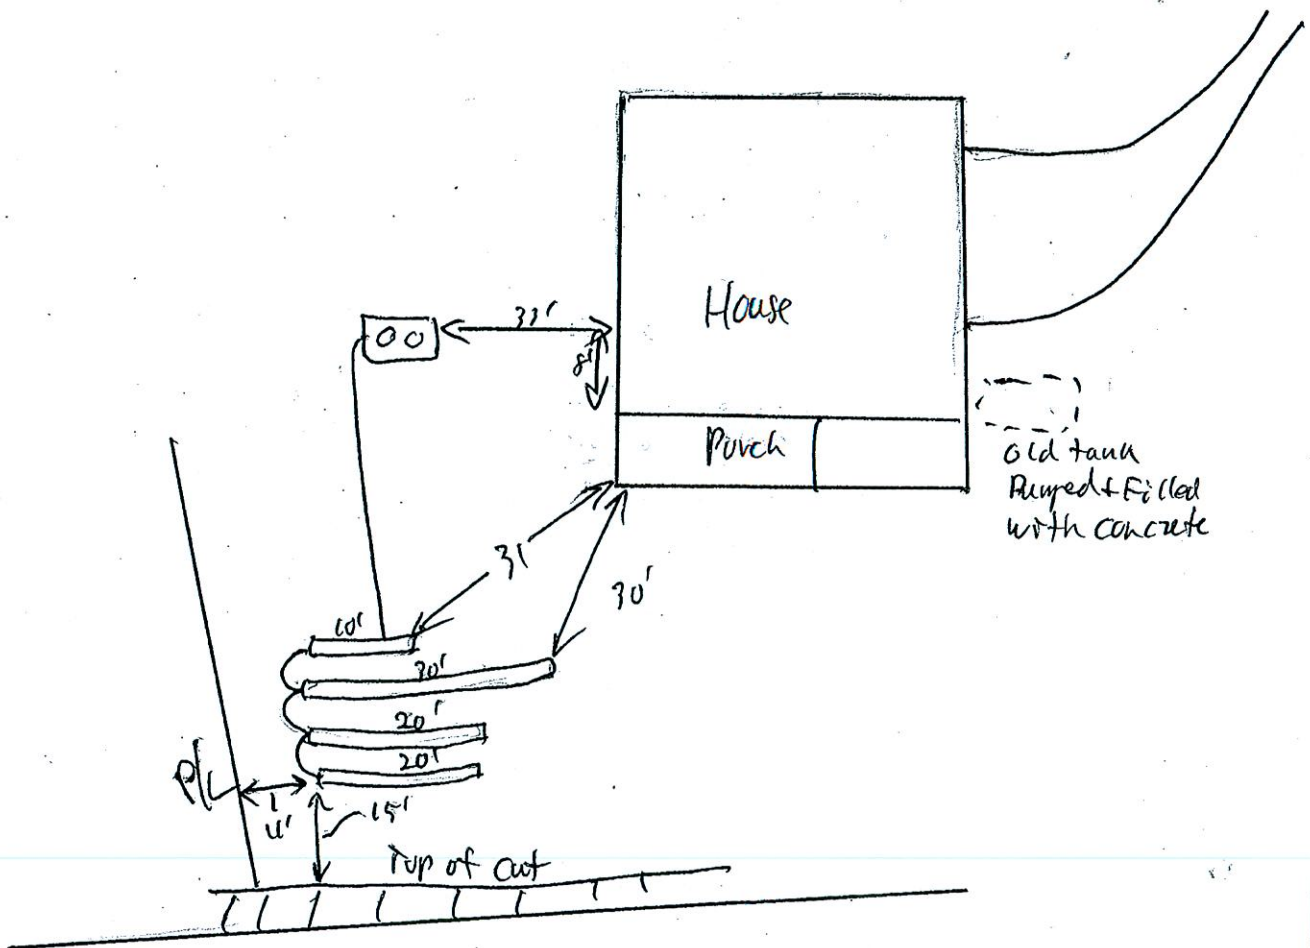

5-23-08 Tank not installed. Tank is plastic manancy and must be set on pea-gravel or sand and back filled for installation. Gardettes. Is Disposed with installer.

Tank set + inspected 5/26/08