



## Henderson County (Environmental) – Existing System Permit

1200 Spartanburg Highway, Suite 100, Hendersonville, N.C. 28792  
 Phone:(828)692-4223  
 Fax:(828)697-4523

**Project No:** 20010117819  
**Permit No:** 20090117828  
**Status:** APPLIED FOR

**Appl. Dt.:** 10/12/2020 **Exp. Dt.:** 2/9/2021  
**Status Dt.:** 10/12/2020

### Owner Information

**Name** : Ross Atherton  
**Address** : 309 Catawba Ave  
 Davidson NC 28036  
**Phone(W)** :  
**Phone(H)** :  
**Phone(M)** :

### Property Information

**PIN #** : 9597883818  
**Address** : 0 Gallimore Rd  
 Flat Rock NC 28731  
**Acreage** : 1.13  
**Subdivision** : Subdivision Steel Magnolias  
**Lot #** : 1.01A  
**Directions** : 0 Gallimore Rd: Spartanburg Hwy, L Upward Rd, R Big Hungry, R Gallimore Rd, drive approx. 1/4 mile on left (just after #685)

**Watershed district** :

### Site Details

**System Type** :  
**System Description** :  
**Line Length** :  
**Line Depth** :  
**Nitrification Sq. Ft.** :  
**Tank #1** :  
**Tank #2** :  
**Tank #3** :

**Notes** :

### Applicant Information

**Name** : Cam Kilpatrick  
**Address** :  
**Phone(W)** :  
**Phone(H)** :  
**Phone(M)** : 828 5514715

### Occupant Information

**Name** : Ross Atherton

### Water Details

**System** : New  
**Source** : PRIVATE

### Property Characteristics

**Type of establishment** : Residential dwelling units  
**Number of establishment** : 3 Bedrooms  
**Septic GPD** : 360  
**Basement** : No  
**Basement Bath** : No  
**Garbage Disposal** : No  
**Multiple Dwelling Units** : No

**Property Notes** : SFD 52' x 40' AND 24' X 24' DETACHED GARAGE; REFER TO 16070111062, 16070113692, 16100113658...LS

### Inspections Conducted


Inspections	Signed Off/User ID	Date	Status	Reason
Existing System Inspection				

### Payment Information

--	--	--	--	--	--	--	--	--	--

Permit	Receipt No.	Fee	Ref#1	Amount	Status	Ref#2	Amount	Status	Ref#3	Amount	Status
MAINPERMIT	20090111000	100.00	CAM KILPATRICK CREDIT-CARD	100.00	PAID						
<b>Total</b>			100.00								


Signature:   
 (Department)

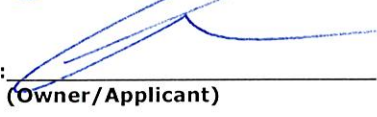Signature:   
 (Owner/Applicant)

Date: 10/12/20

**ore Road (SR 1956)**

Public Access Point

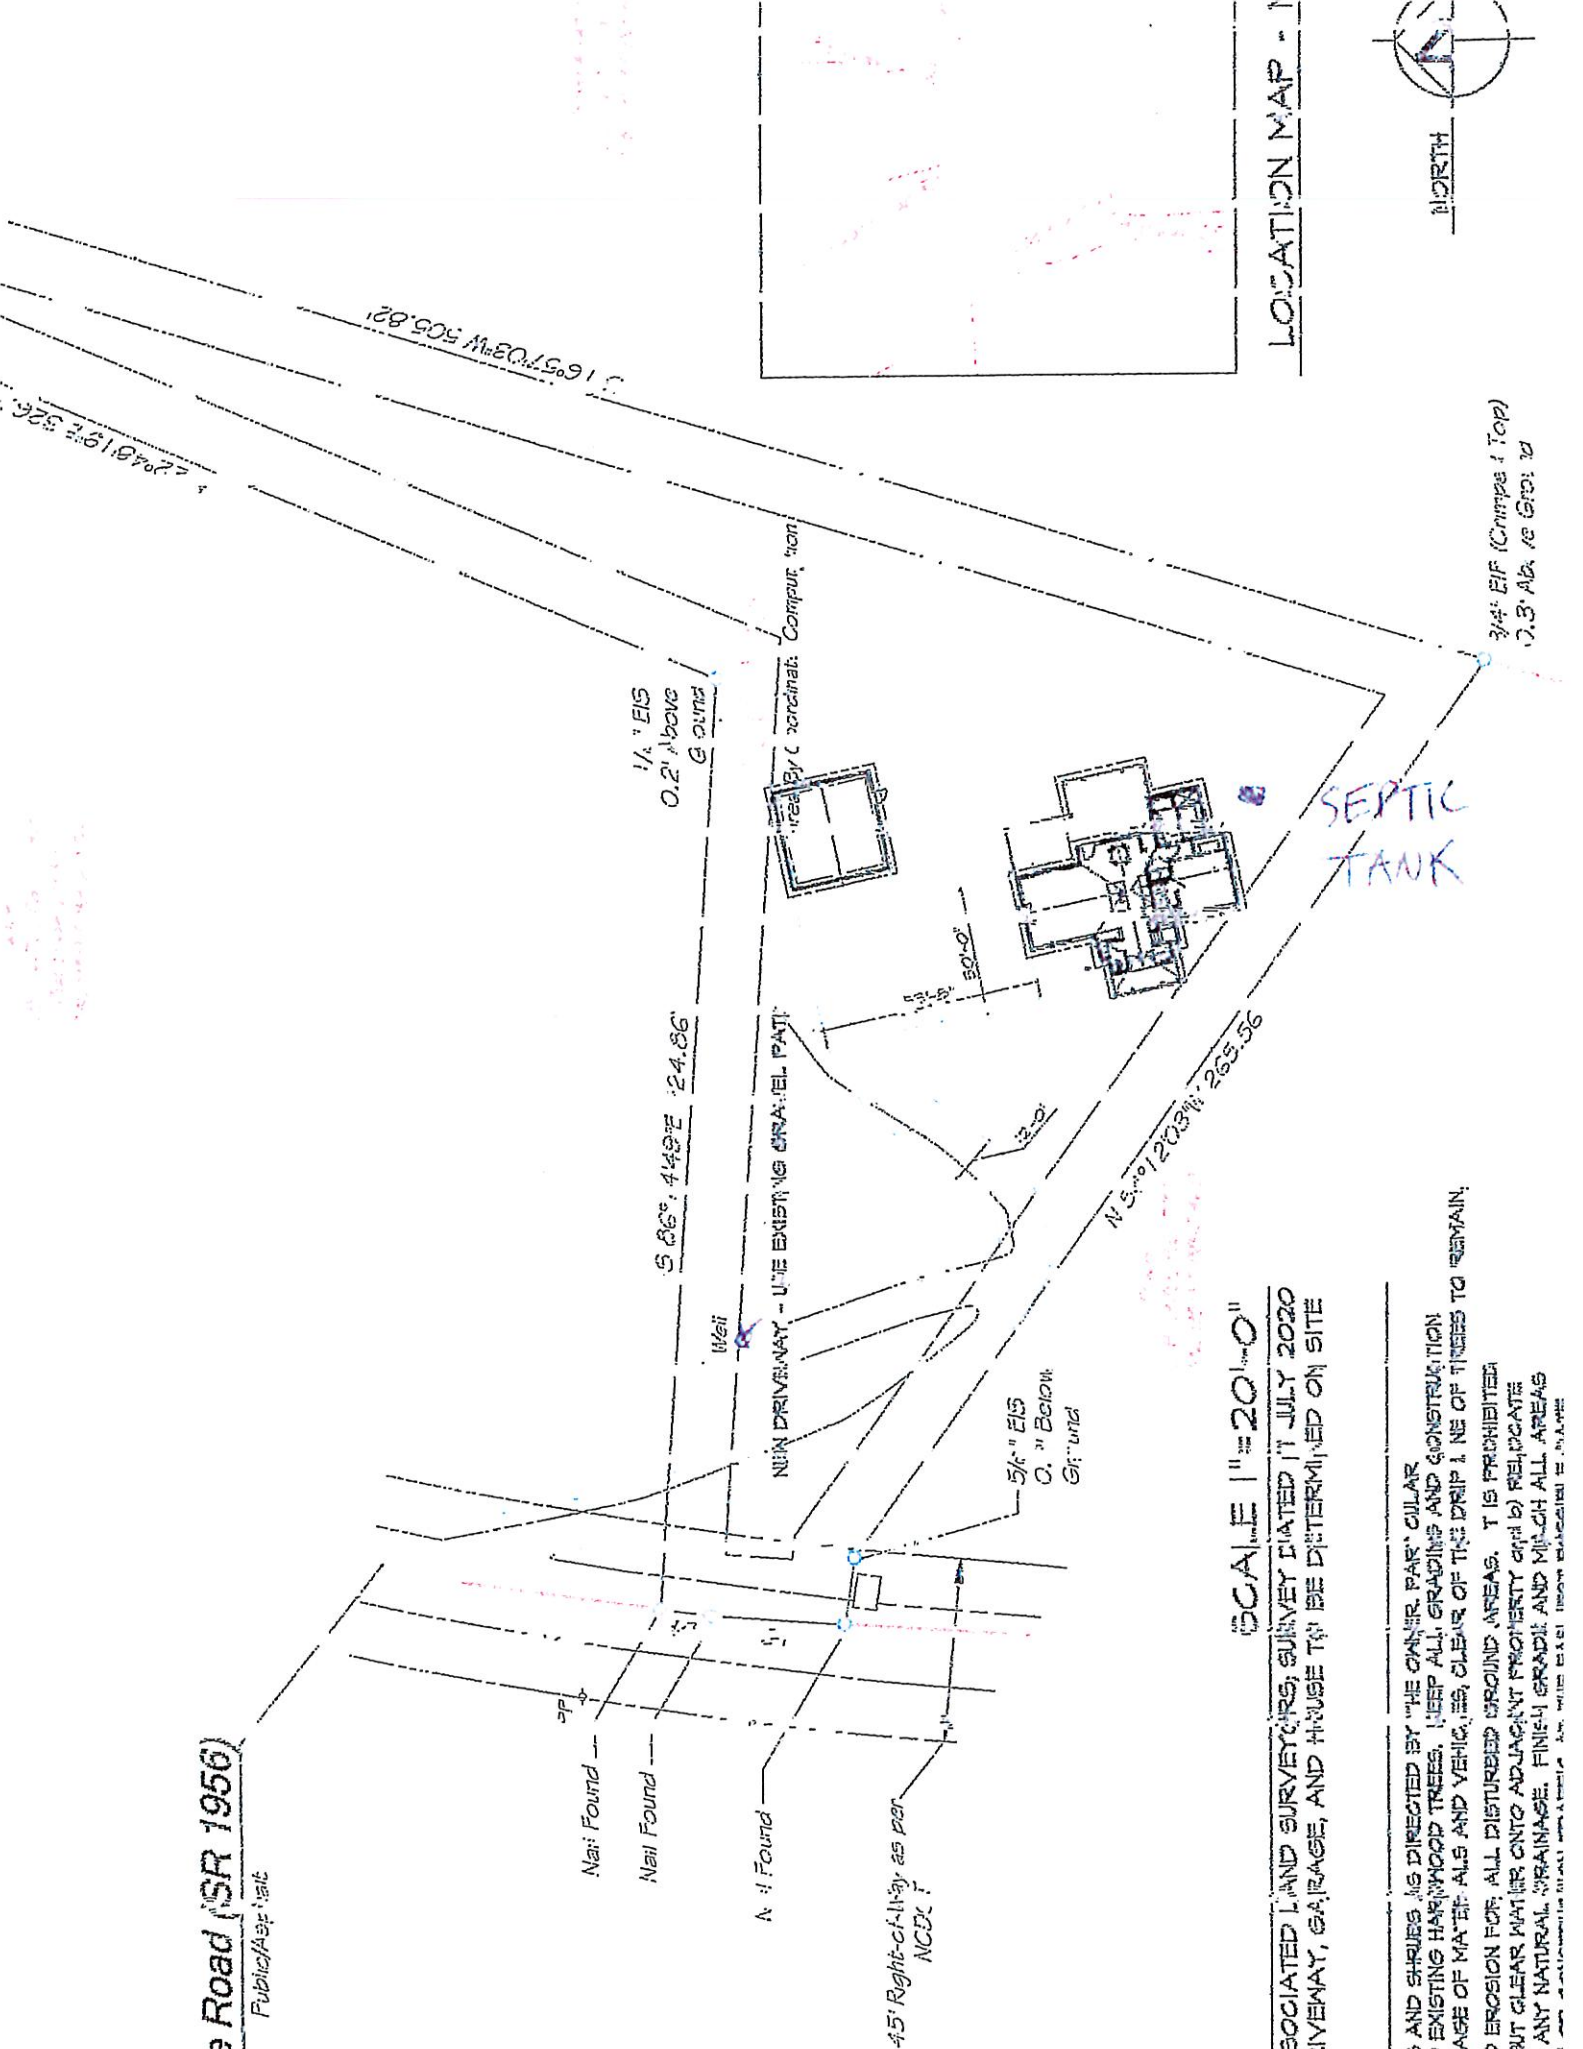


**SCALE 1" = 20'-0"**

ASSOCIATED LAND SURVEYORS, SURVEY DATED 17 JULY 2020  
 DRIVEWAY, GARAGE, AND HOUSE TO BE DETERMINED ON SITE

SEES AND SHRUBS AS DIRECTED BY THE OWNER. PAR' CULAR  
 TO EXISTING HARDWOOD TREES. KEEP ALL GRADING AND CONSTRUCTION  
 DRAINAGE OF WATER AWAY FROM ALLS AND VEHICLES, CLEAR OF THE DRIP LINE OF TREES TO REMAIN.  
 AND EROSION FOR ALL DISTURBED GROUND AREAS. IT IS PROHIBITED  
 S BUT CLEAR WATER ONTO ADJACENT PROPERTY AND TO RELOCATE  
 OF ANY NATURAL DRAINAGE. FINISH GRADABLE AND MICH ALL AREAS  
 SHALL BE RESTORED TO ORIGINAL CONDITION. SEE WITH EACH FROM EMBLEMED IN THE PLAN.

**LOCATION MAP - 1**

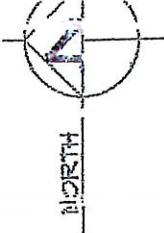

3/4" EIS (Cripples Top)  
 0.3' Above Ground



Gallimore Road (SR 1956)  
Public Use Site

**SITE PLAN**  
INFORMATION FROM ASSOCIATED LAND SURVEYING SURVEY DATED 17 JULY 2020  
FINAL LOCATION OF DRIVEWAY, GARAGE, AND HOUSE TO BE DETERMINED ON SITE


**GENERAL SITE NOTES**

PROTECT ALL EXISTING TREES AND SHRUBS AS DIRECTED BY THE OWNER. PARTICULAR ATTENTION SHALL BE PAID TO EXISTING HARDWOOD TREES. KEEP ALL GRADING AND CONSTRUCTION OPERATIONS, INCLUDING STORAGE OF MATERIALS AND VEHICLES, CLEAR OF THE TRIP LINE OF TREES TO REMAIN. CONTROL EROSION AND SEDIMENT FOR ALL DISTURBED AREAS. IT IS PROHIBITED TO DISCHARGE ANYTHING BUT CLEAN WATER ONTO ADJACENT PROPERTY AND TO RELOCATE THE POINT OF DISCHARGE OF ANY NATURAL DRAINAGE. FINISH GRADE AND MULCH ALL AREAS DISTURBED BY CONSTRUCTION OR CONSTRUCTION TRAFFIC AT THE EARLIEST POSSIBLE DATE. SEED OR MULCH EROSION PRIOR TO INSTALLATION OF EXTERIOR FINISH MATERIALS TO A 100 CLAY SPLATTER STAINING.

CONTRACTOR USE ALL SEPTIC SYSTEM IN CONFORMANCE WITH HENDERSON COUNTY HEALTH DEPARTMENT UTILITIES INCLUDING POWER AND TELEPHONE SHALL BE EXTENDED UNDERGROUND FROM UTILITY COMPANY SERVICES TO NEW RESIDENTIAL TERMINALS.

CONTRACTOR SHALL KEEP THE BUILDING CONSTRUCTION AND BUILDING SITE SAFE, CLEAN, AND FREE FROM LITTER, DEBRIS, AND EXCESS CONSTRUCTION WASTE MATERIALS AT ALL TIMES DURING THE CONSTRUCTION PERIOD. WASTE MATERIALS SHALL BE PROPERLY DISPOSED OF ON A REGULAR BASIS. PROVIDE A LITTER CONTAINER AND REQUIRE WORKERS TO USE IT.

SCALE 1" = 20'-0"

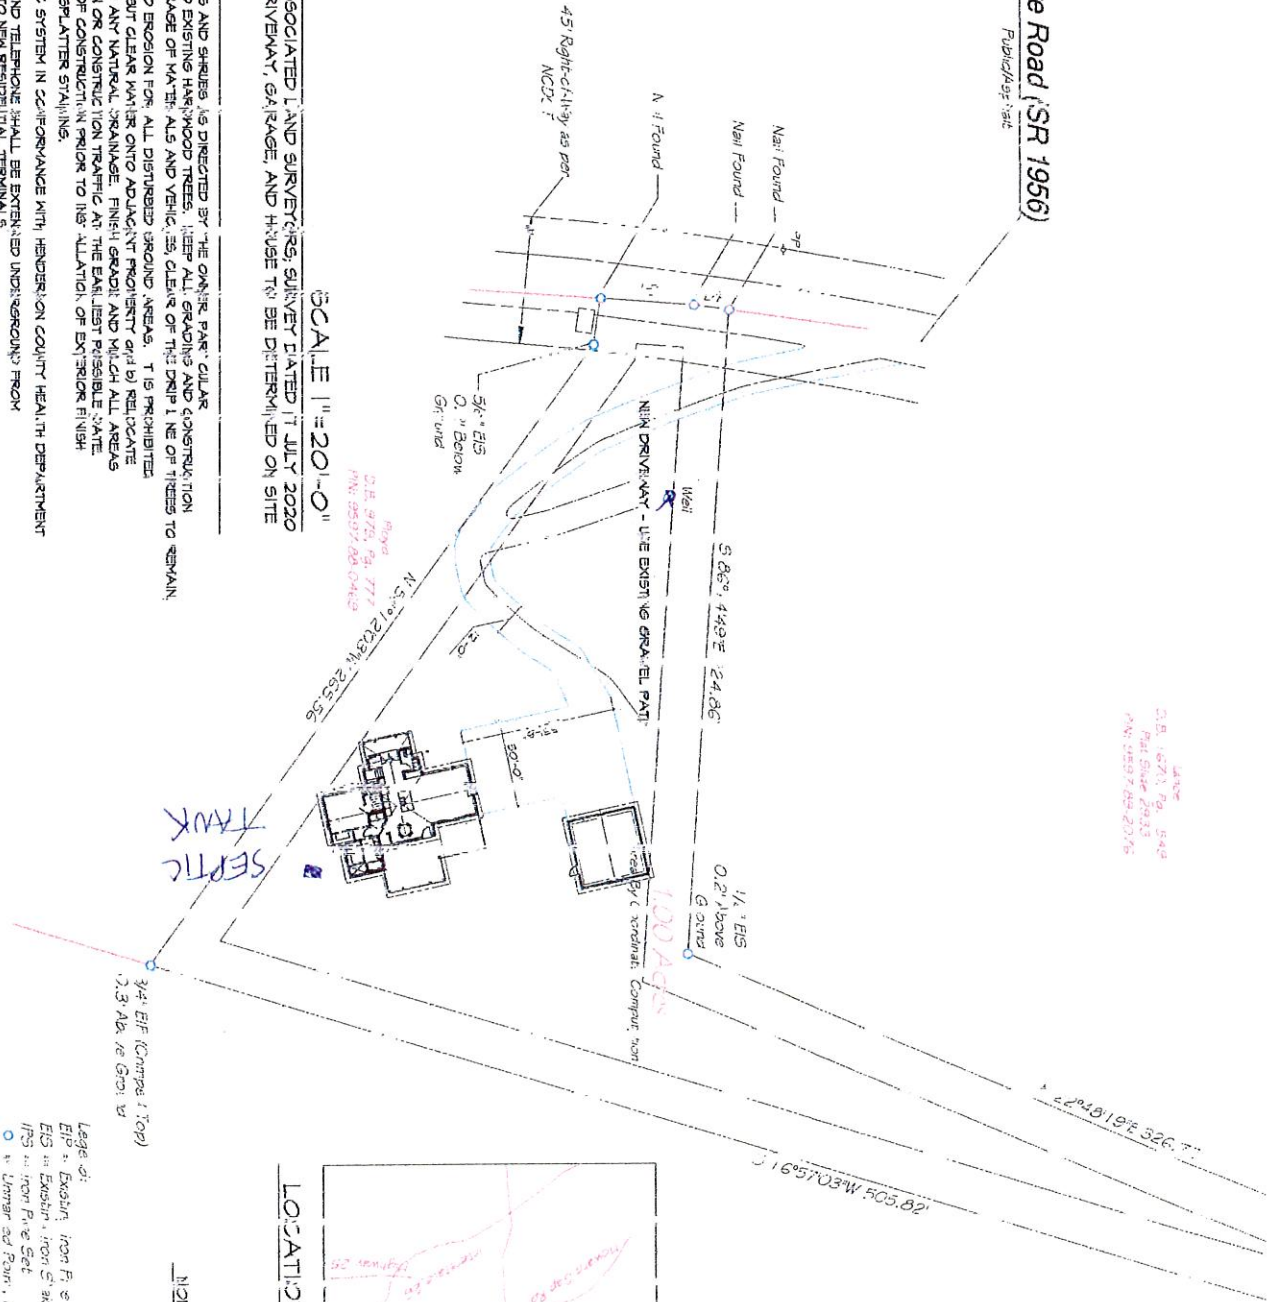


LOCATION MAP - NTS



- Legend:
- Exp = Existing Iron Pipe
- ES = Existing Iron Pipe
- FP = Iron Pipe Set
- = Location of Run, Unless Otherwise Noted
- SCM = Right of Way
- PP = Power Pole

DATE: 07/17/20  
FILE: 1956-2020  
NO: 2020-00048

DATE: 07/17/20  
FILE: 1956-2020  
NO: 2020-00048

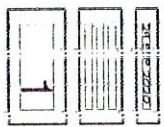

**the big hungry house**  
RESIDENCE FOR ROSS AND MELISSA ATHONTON  
00 GALLIMORE ROAD - HENDERSONVILLE - NORTH CAROLINA

**casa design studio. pllc**  
28a espresso lane  
hendersonville, nc  
(628)216-8198

