

Complete



Y \ecQe_

Henderson County Department of Public Health

Steven E. Smith, MPA, Health Director | Seth Swift, REHS, Environmental Health Director

1200 Spartanburg Highway, Suite 100, Hendersonville, NC 28792

Main Phone: (828) 694-6060 | Administration FAX: (828) 697-4523

PublicHealth

Prevent. Promote. Protect,

Septic and/or Well Permit Search Request

Please submit your completed request to Fax # (828) 697-4523 or to email address: HCEnvHlth@hendersoncount.nc.gov

MEADOW OAKS Lot# 16
Address: 2 WARBLER DR, FLETCHER NC 28792

+ Howard Grass
+ Warbler, Dic
on (R)

PROPERTY INFORMATION

Subdivision:

Current Address:

List Current and All Previous Owners of Property: BLACK, JAMES NORMAN
JONES, BRUCE A / JONES DARLENE P. 2000
HORTON, RYAN L 1998

2007

0.40 acre

Previous Road Name(s):

Year Residence was Built: 1996 PIN: 9652825958

YOUR CONTACT INFORMATION:

Date of Request: 11/19/2020

Name: IRIS ZOHAR Phone #: (828) 593-8050

FAX #: _____ EMAIL: iriszohar@Beverly-hanks.cc

T-17757

2453

ENVIRONMENTAL HEALTH DEPARTMENT SEARCH RESULTS:

Search Completed by: EK Date: 11/20/20

Record Located Copy Attached *Please verify the information.*

No Record Located

Incomplete property information provided unable to process

HENDERSON COUNTY HEALTH DEPARTMENT
COMPLETION PERMIT

FOR CONVENTIONAL SYSTEM
PERMIT NUMBER

C No. 15059

Owner Nathan Benson Date 1-21-93

Building Contractor _____

Septic Tank Installer Bud Laughlin

Lot No. 116 Development MEADOW OAKS

Location 25 N (R) HOWARD GAP (L) into Subdiv
1st Lot (P1)

House Mobile Home Other

Lot Size 1/2 AC

Basement Yes No Basement Plumbing Yes No

Water Supply - Community City Individual

No. Bedrooms 3 Design Flow GPD 360

I NO. 17757

WI NO. _____

PIN # 99-44196

NEW CONSTRUCTION

REPAIR

ADDITION

PRE-EXISTING TANK

Tank Size K-1000

Drainfield 900 Sq. Ft.

Stone Depth 12 Inches


VALID ONLY FOR USE AS DESCRIBED ABOVE

Received By:

Charles F. [Signature]
APPROVED FOR MATERIAL & WORKMANSHIP ONLY

Issued By:

Vicki Harris
ENVIRONMENTAL HEALTH SPECIALIST

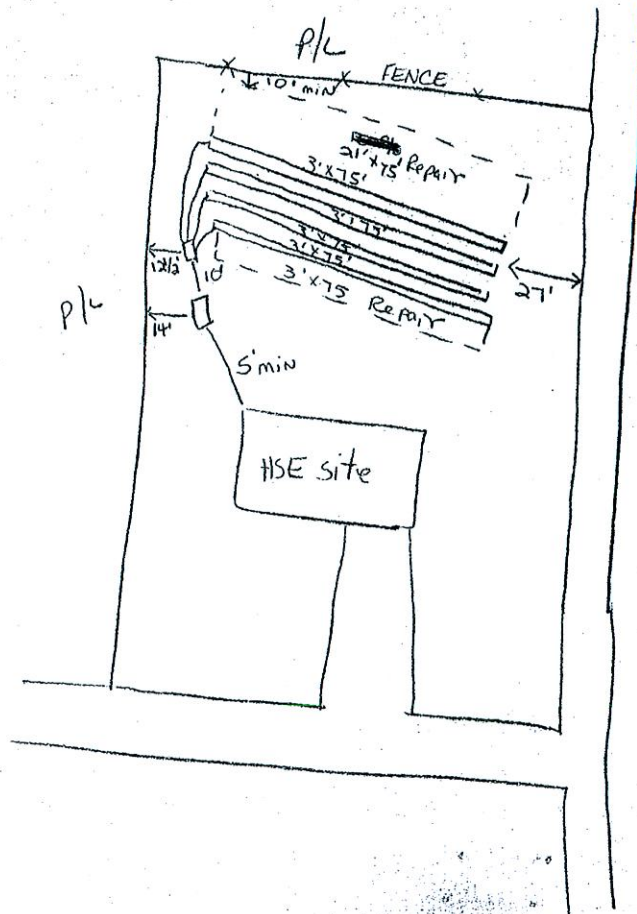

Henderson County Health Department

1347 SPARTANBURG HIGHWAY
HENDERSONVILLE, NORTH CAROLINA 28792

THOMAS L. JOHNSON
DIRECTOR

TELEPHONE
704-692-4228

WELL CERTIFICATE OF COMPLETION I-17757

PERMIT NO: WC - 1342

Owner or Builder NATHAN BENSON Date 6-6-96

Mailing Address of Applicant 145 BROOKSIDE CAMP RD. Phone 693-5493

Pin No. _____ Subdivision/Park MEADOW OAKS Lot # 16


Location 25 N TO FLETCHER TO (R) ON HOWARD GAP ROAD TO MEADOW OAKS ON (L). TO 1ST LOT ON (R)

Type DRILLED Size 6 1/4" Depth 325' Casing Depth 100'

Grout CONCRETE/CEMENT Yield 20 GPM Static Level _____ Water Zone _____

Contractor/Driller CALDWELL WELL DRILLING

Site Sketch

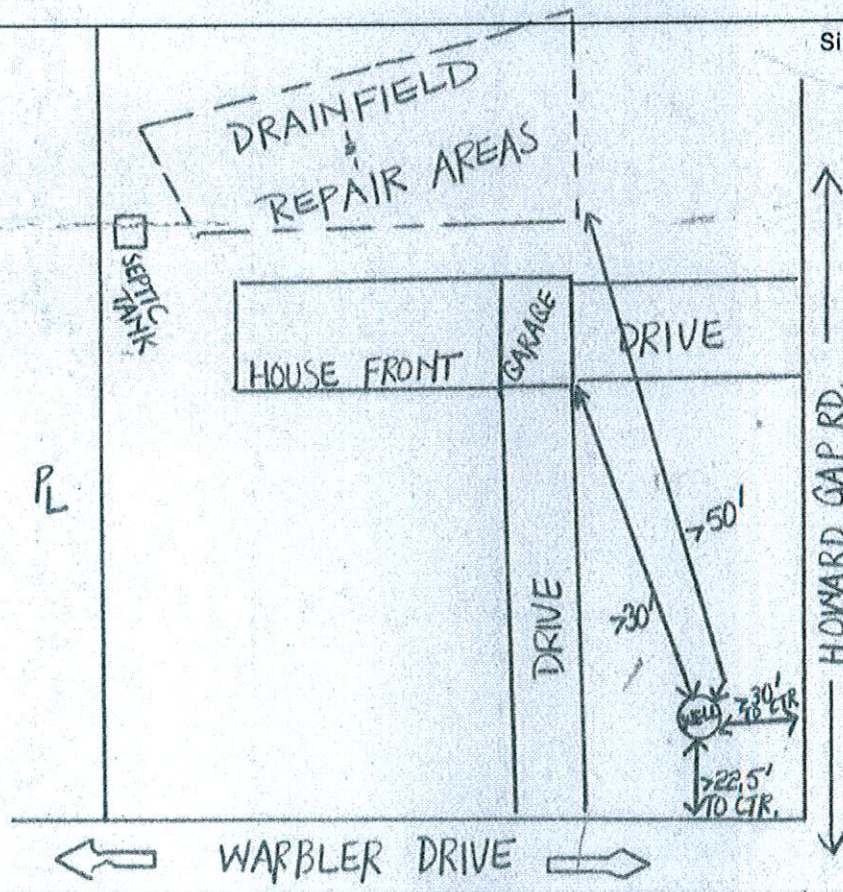

Date Issued 6-6-96 Environmental Health Specialist Kissie Sutton Red, RPH

Permit Received By _____