
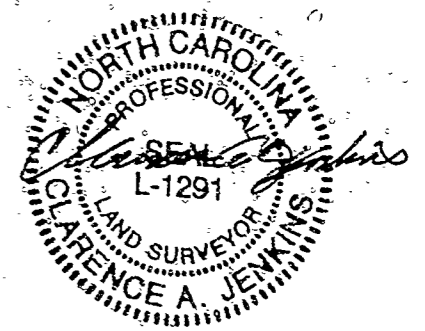
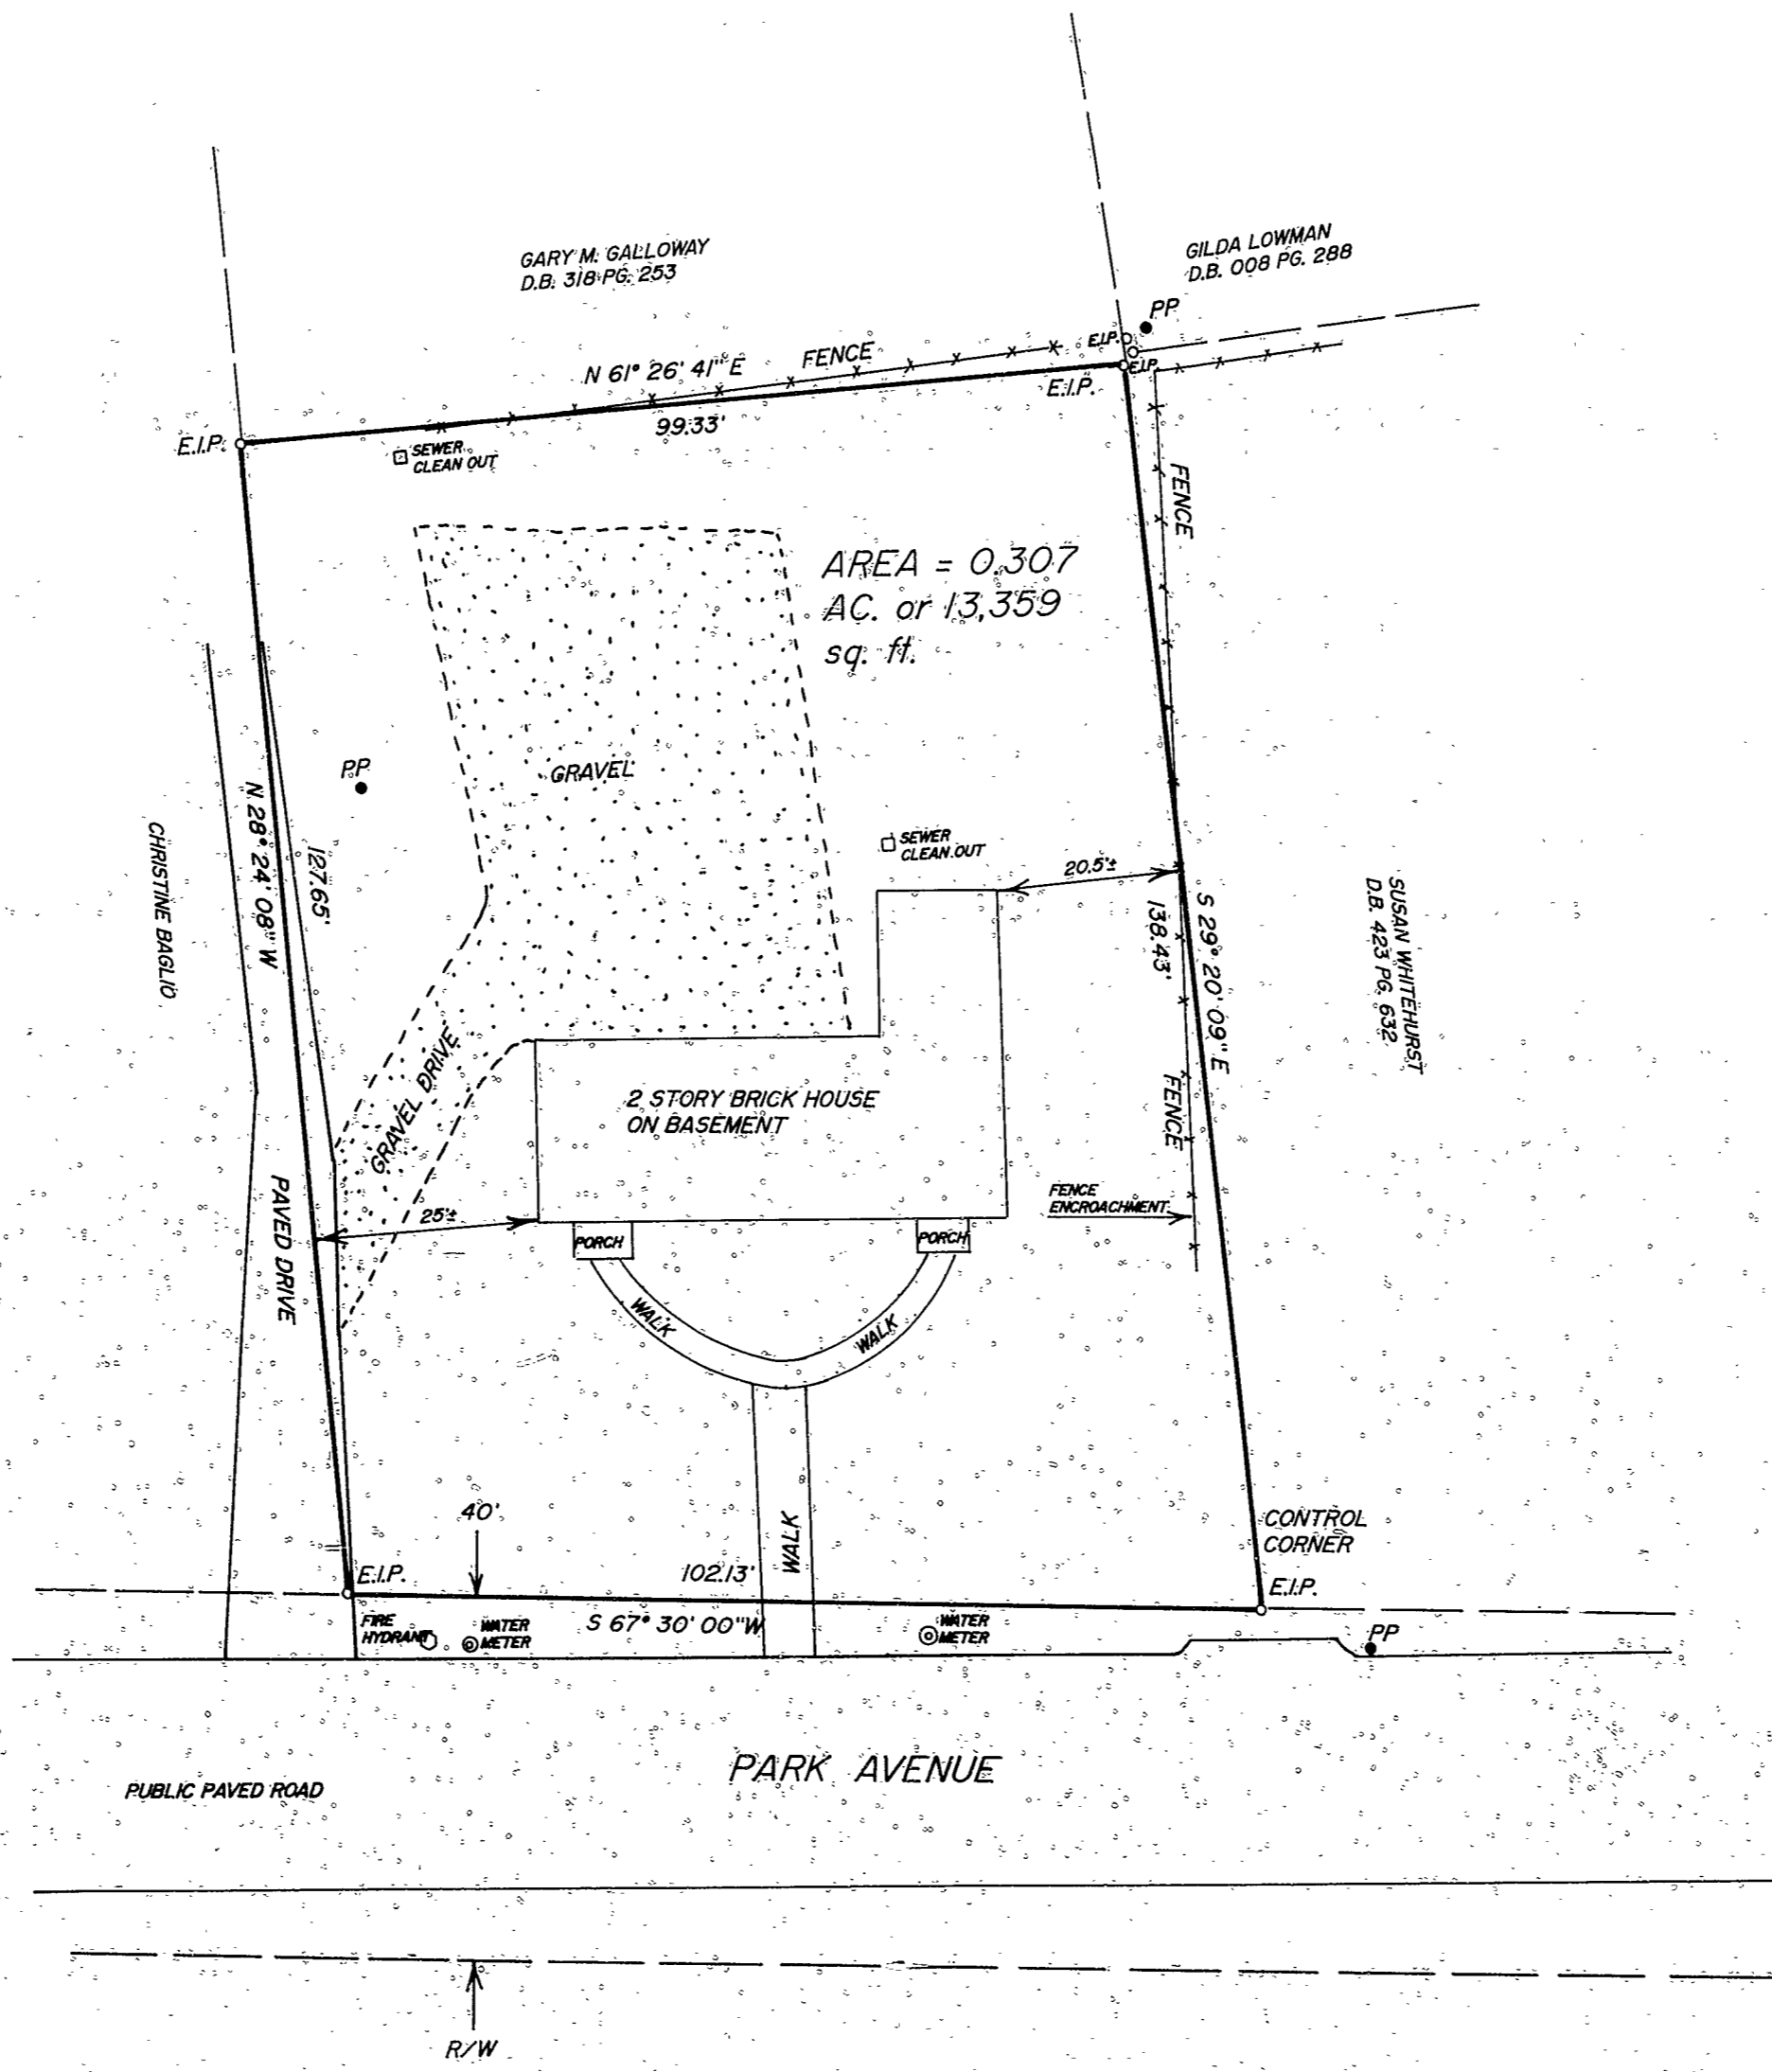
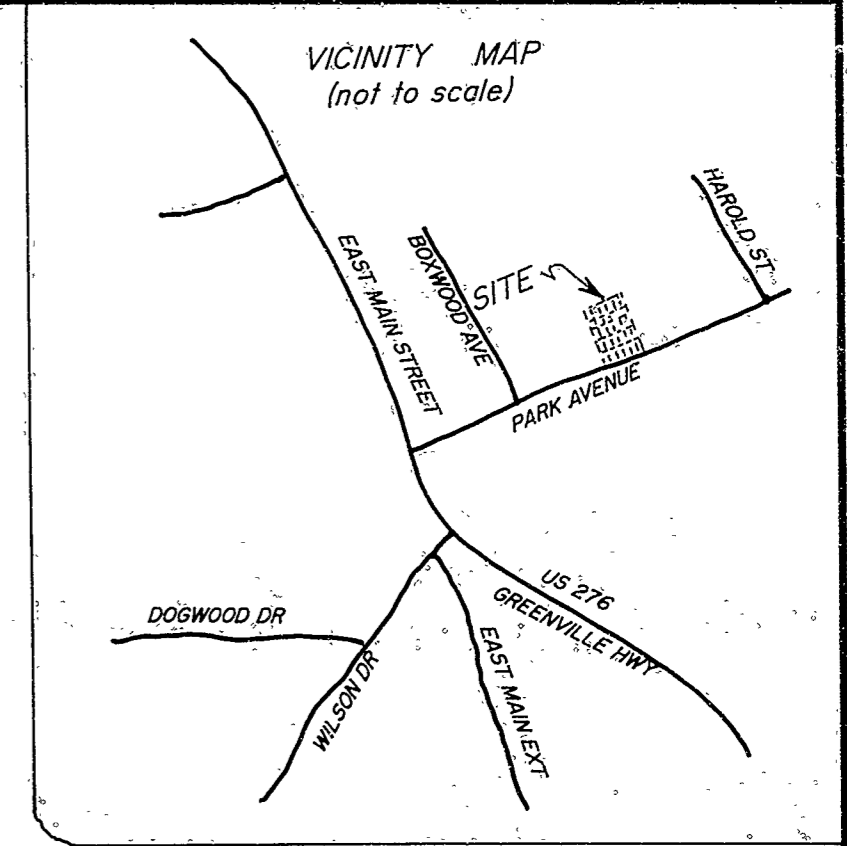


9, 781

Slide 9 slide 781

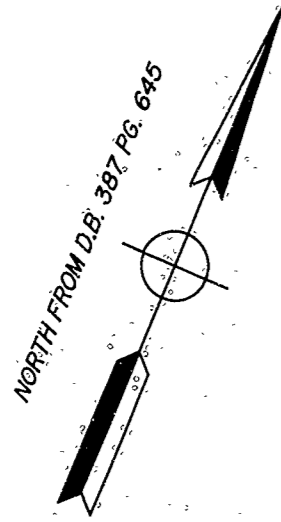

LEGEND & NOTES:

E.I.P.-EXISTING IRON PIPE OR PIN FOUND
PP-POWER POLE
R/W-RIGHT-OF-WAY
D.B.-DEED OR DOCUMENT BOOK PG.-PAGE
THIS SURVEY IS OF AN EXISTING PARCEL OF LAND.
THERE IS NO HORIZONTAL CONTROL WITHIN 2,000'
THIS PROPERTY IS ZONED R2.
THIS PROPERTY IS SUBJECT TO RESTRICTIONS, EASEMENTS,
ROADWAYS, RIGHTS-OF-WAY, ORDINANCES AND ETC. AS PER
RECORDS AND OR PLATS INDICATE.

The foregoing certificates of Clarence A. Jenkins,
a professional Land Surveyor, and
a Review Officer, are certified to be correct. This
plat was presented for registration and recorded in
this office in Plat File # 9 Slide 781 this
the 9 day of August, 2002, A.D. at
9:10 o'clock A.M.

State of North Carolina
County of _____
I, _____, Review Officer of
_____ County, certify that the map or plat
to which this certification is affixed meets all
statutory requirements for recording.
Review Officer _____ Date _____

N.C.G.S. 47-30 (f) (ii) c.
I, Clarence A. Jenkins, P.L.S., certify that this survey is of an existing parcel
of land and does not create a new street or change an existing street.

I, Clarence A. Jenkins, P.L.S., certify that this
plat was drawn under my supervision from an actual
survey made under my supervision from an actual
survey recorded in Book 387 Page 645; that the
ratio of precision as calculated is 1 : 10,000;
that this plat was prepared in accordance with
G.S. 47-30 as amended. Witness my original signature
Registration number and seal this 10th day of
JULY, A.D., 2002

Clarence A. Jenkins, P.L.S.
Registration Number L-1291

I, Clarence A. Jenkins P.L.S. certify that this
property is not located in the 100 year flood zone
as per Flood Insurance Rate Maps.

Register of Deeds
By: Vickie L. Edwards
Deputy

36 B 38 PARK AVENUE
PROPERTY OF:
MARION S. LATHAM
AND
ROSLYN A. BANKS
CITY OF BREVARD TWP., TRANSYLVANIA COUNTY, N.C.
DEED REFERENCE: DEED BOOK 387 PAGE 645
TAX PIN: 8585-79-3548-000

SCALE: 1" = 20' DATE: JULY 10, 2002

Surveyed By
Clarence A. Jenkins, P.L.S.
307 Water Oak Suites, East Main St.
Brevard N.C. 28712
Tele. # 884-5880