


82 NEW CASTLE ROAD, BREVARD, NC (REVISED)

TOTAL HEATED LIVING AREA


MAIN LEVEL = 2540 sf
SECOND LEVEL = 1127 sf
LOWER LEVEL* = 1726 sf
Below Grade*

TOTAL = 5393 sf

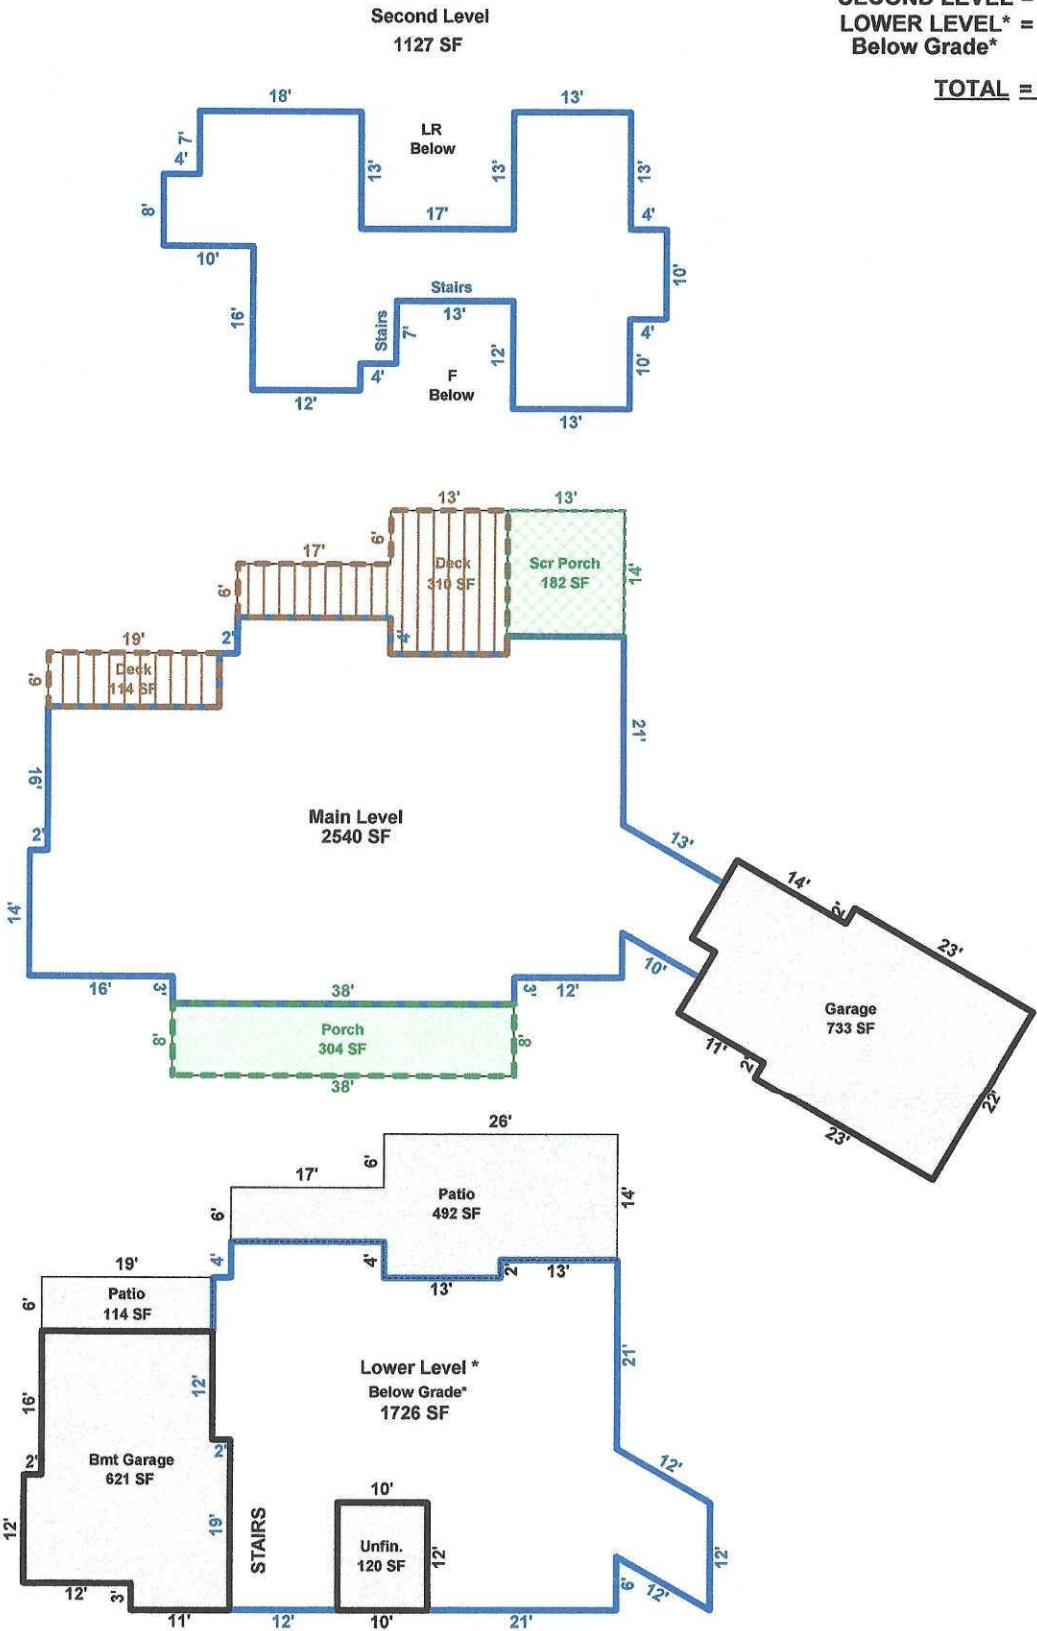

Prepared by Diane L. Jetton, HMS (828)553-0171


82 NEW CASTLE ROAD, BREVARD, NC (REVISED)

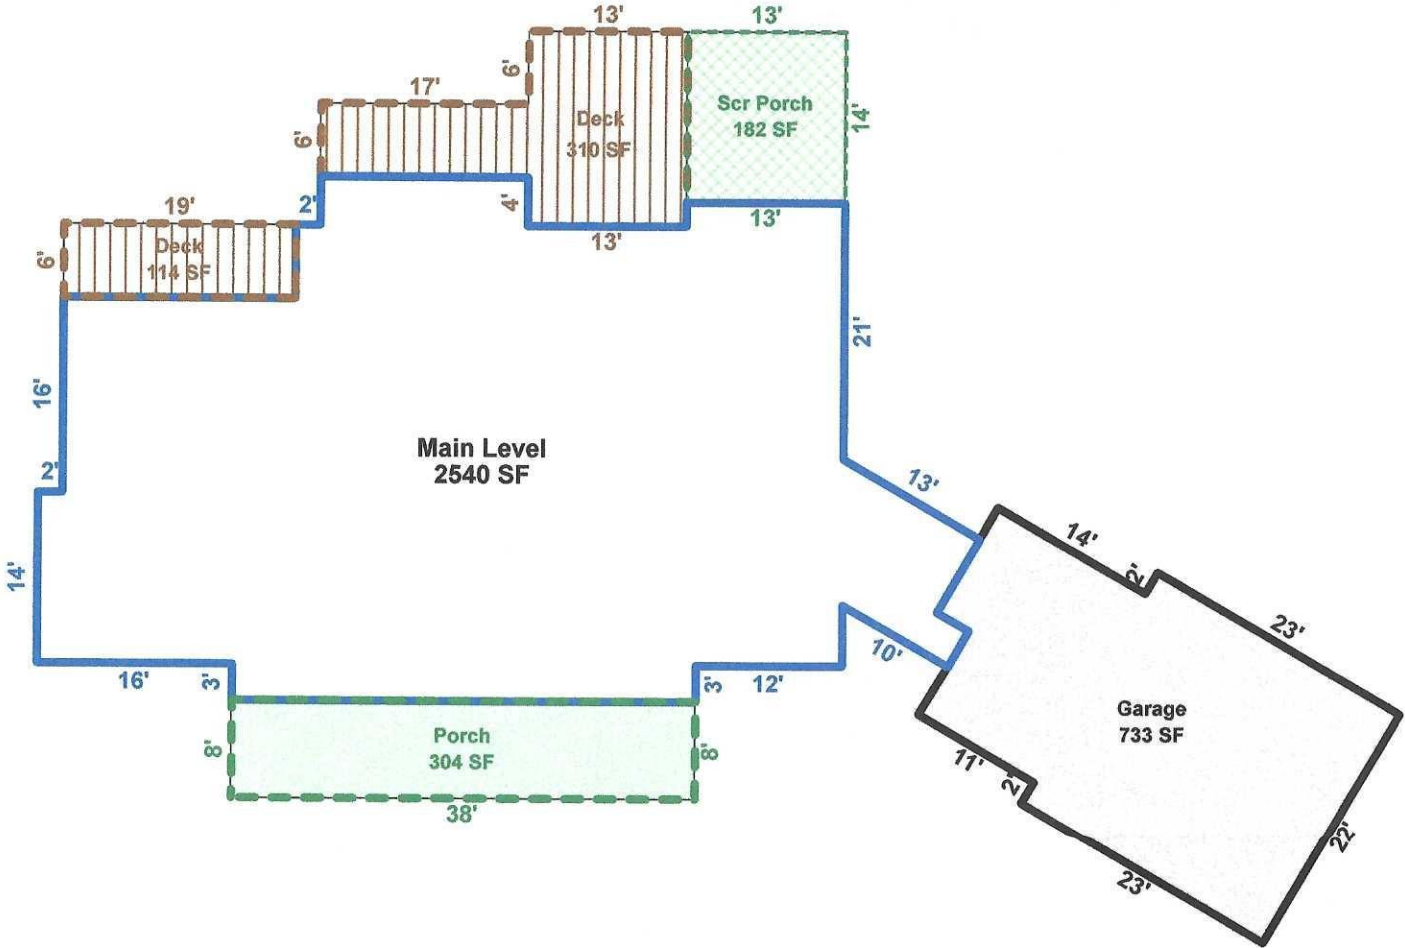

Prepared by Diane L. Jetton, HMS (828)553-0171


Second Level

1127 SF

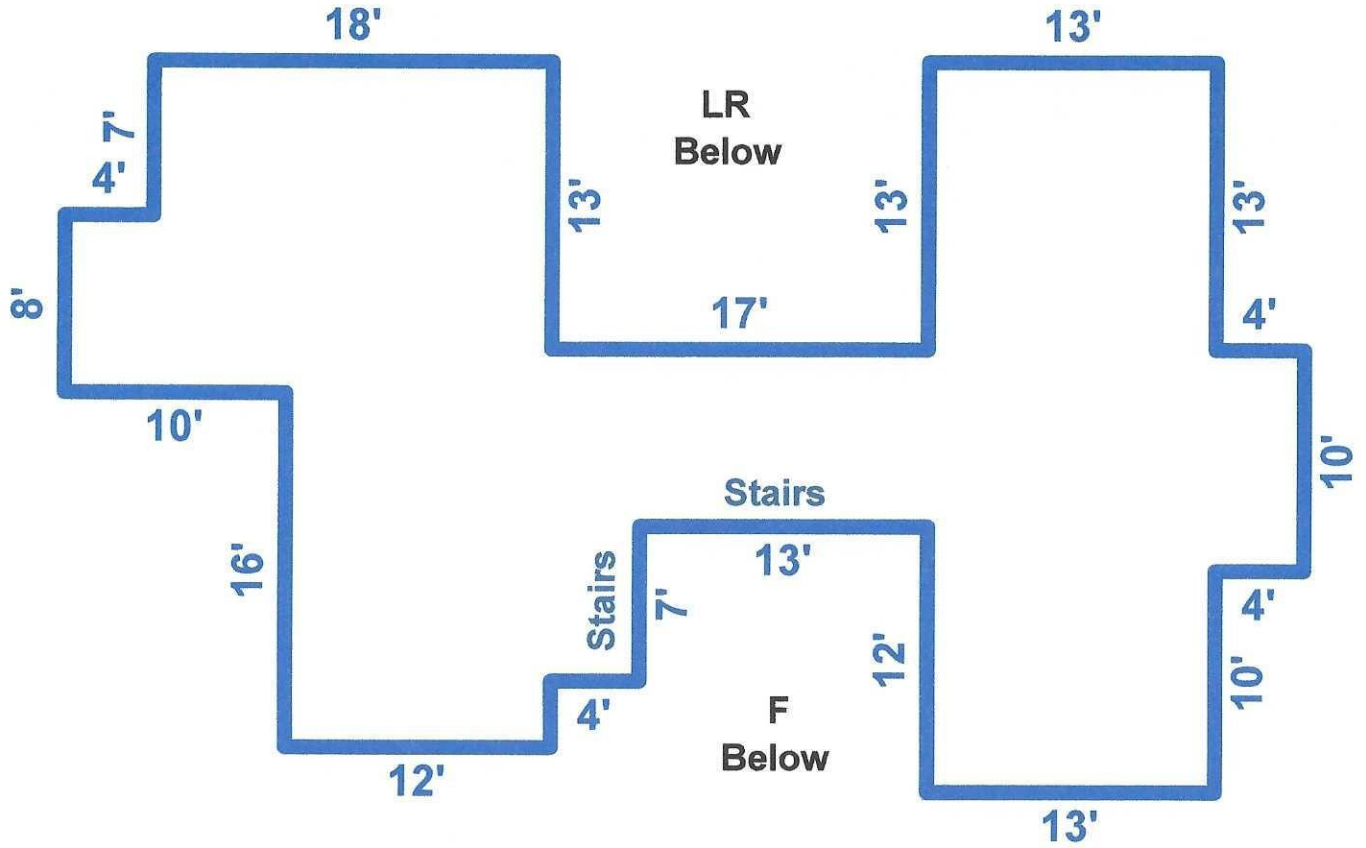

Prepared by Diane L. Jetton, HMS (828)553-0171

82 NEW CASTLE ROAD, BREVARD, NC (REVISED)

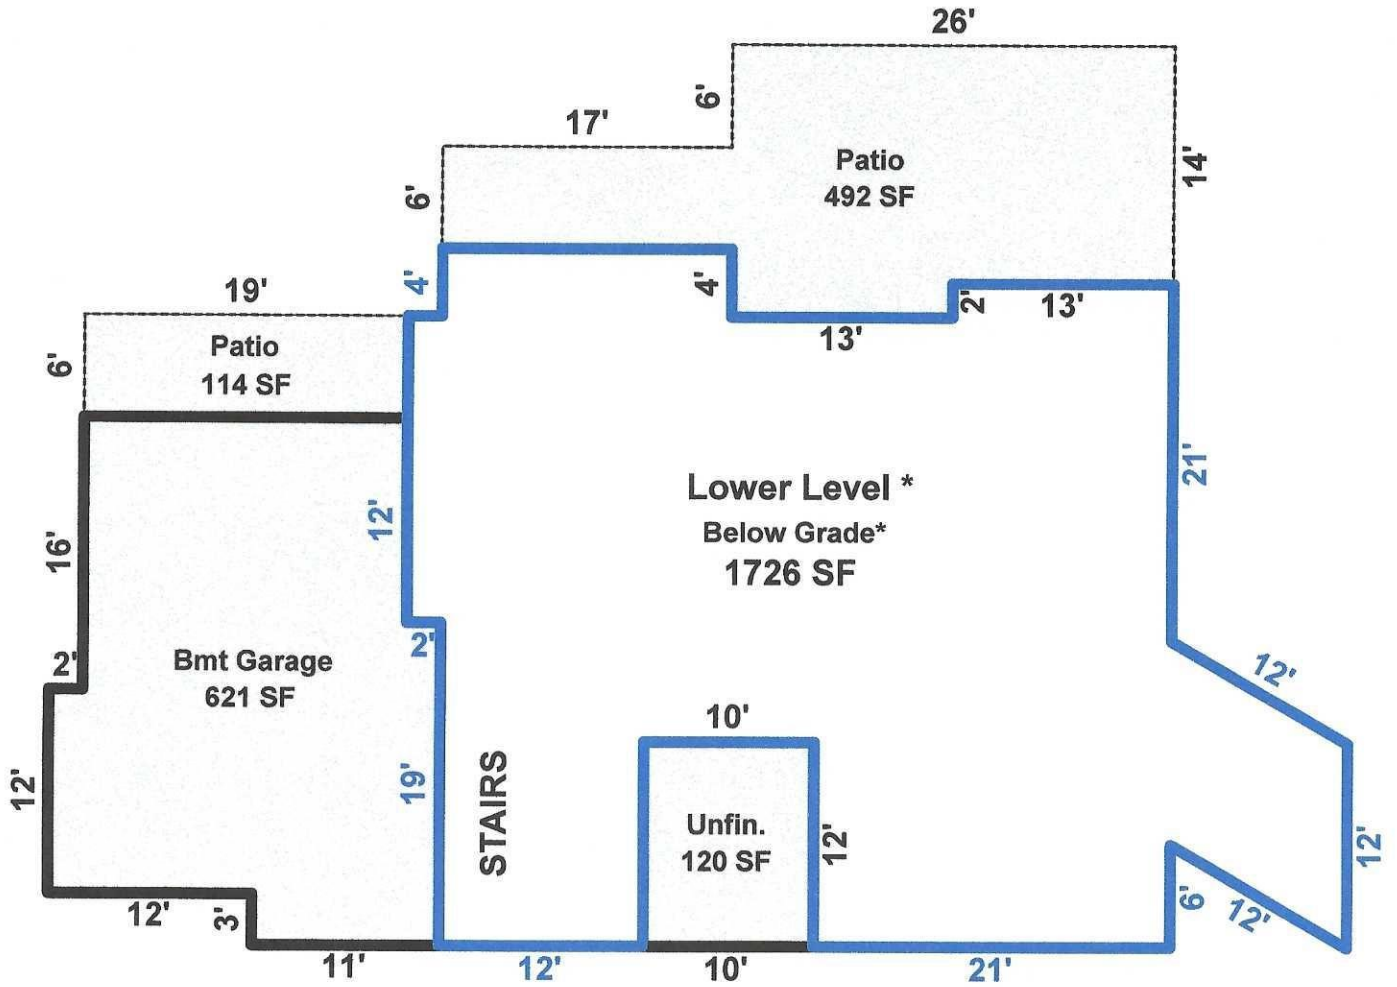

Prepared by Diane L. Jetton, HMS (828)553-0171