

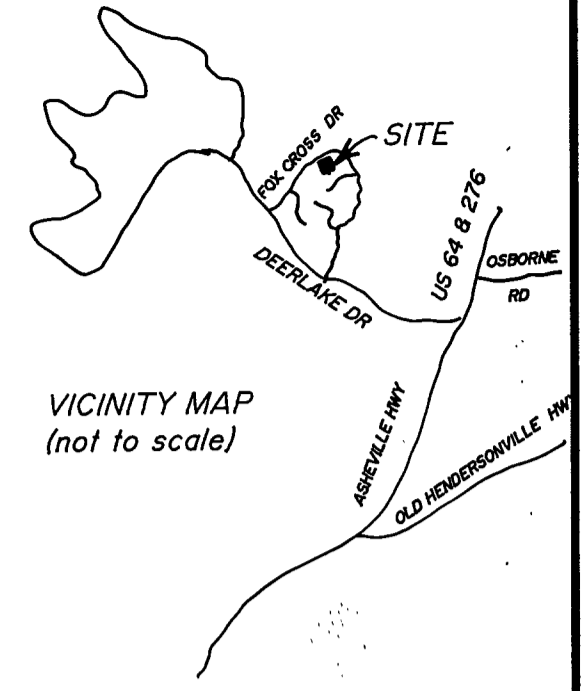


File 11 slide 601

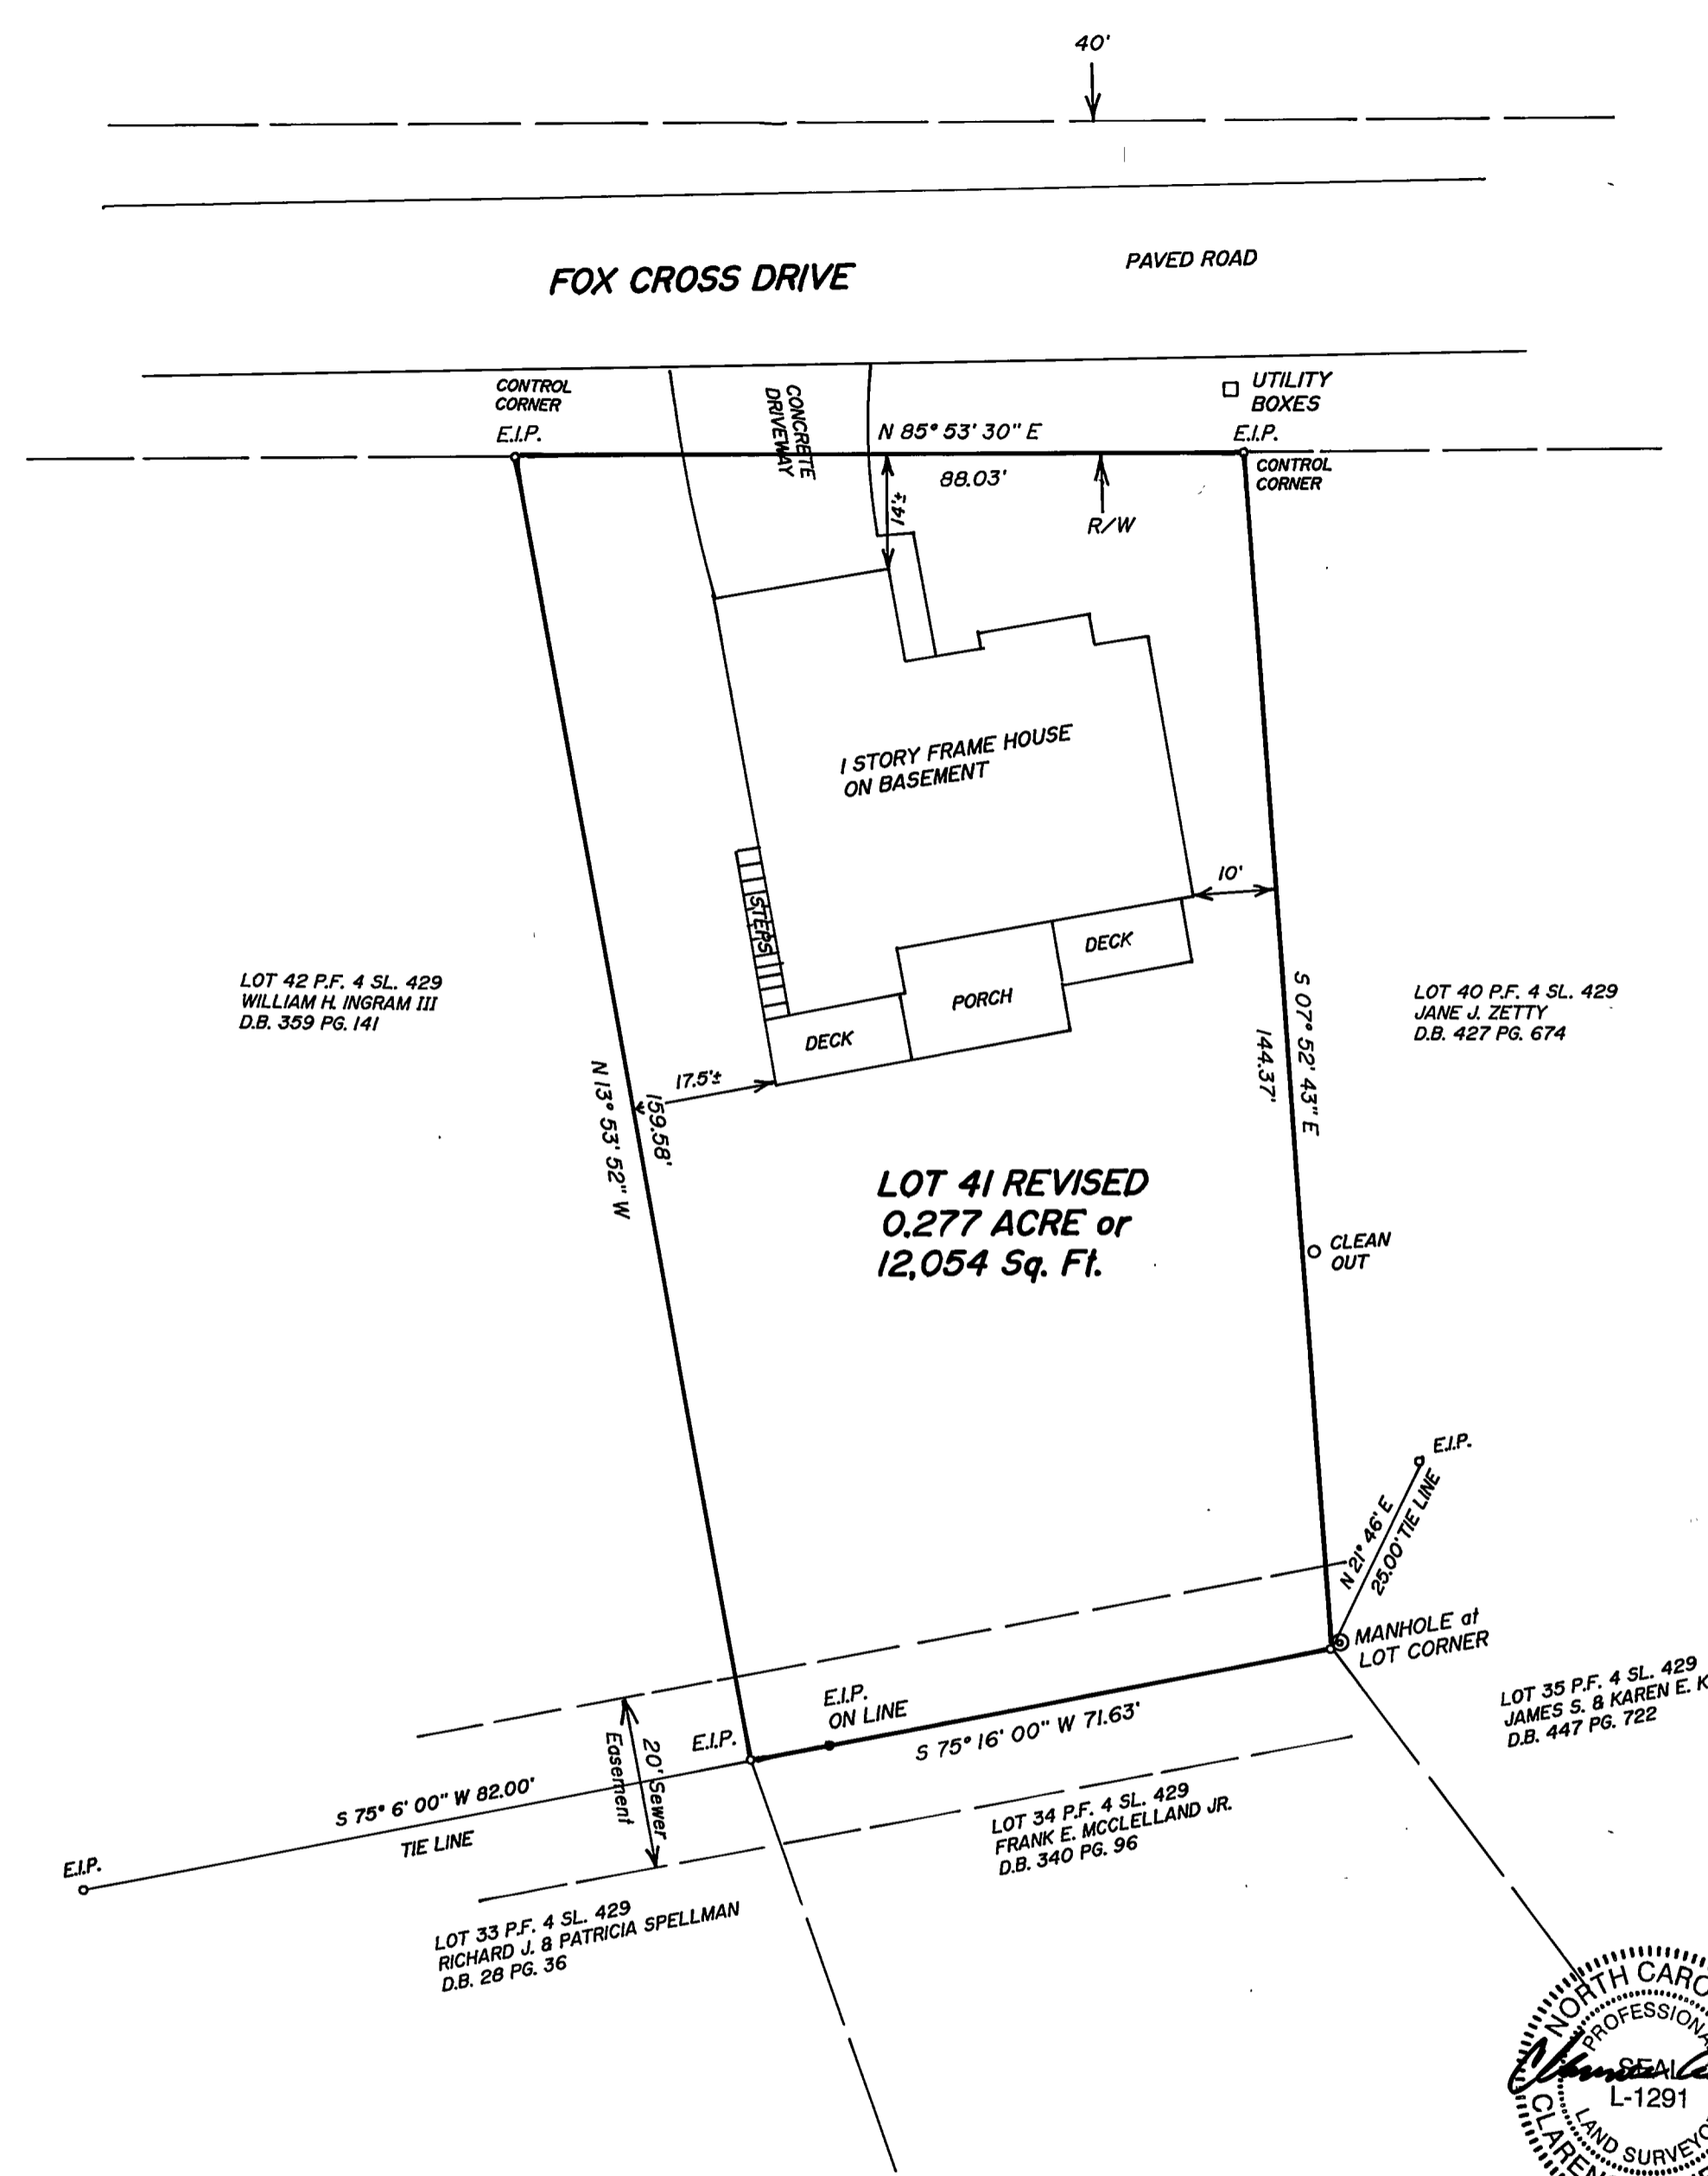

2006001267  
TRANSLYVANIA CO, NC FEE \$21.00  
PRESENTED & RECORDED:  
02-10-2006 02:22:24 PM  
CINDY M ORNBEY  
REGISTER OF DEEDS  
BY: TERESA D MORTON  
DEPUTY REGISTER OF DEEDS  
PF 11  
PG:601-601

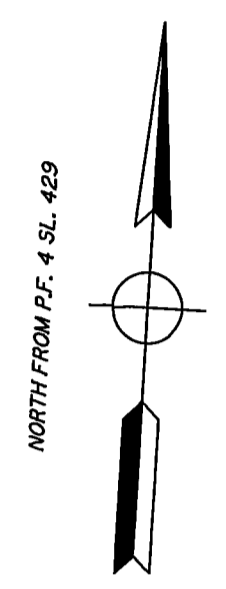

120 FOX CROSS DRIVE  
SURVEY FOR:  
**ALLEN SALOWE**  
AND  
**CYNTHIA SALOWE**  
LOT 41 REVISED OF THE COTTAGES AT DEERLAKE VILLAGE  
BREVARD TOWNSHIP, TRANSLYVANIA COUNTY, N.C.  
DEED REFERENCE: DEED BOOK 403 PAGE 289  
PLAT REFERENCE: PLAT FILE 4 SLIDE 429  
TAX PIN: 8586-77-7603-000

0 20 40  
SCALE: 1" = 20' DATE: DEC. 22, 2005

LEGEND & NOTES:

E.I.P.=EXISTING IRON PIPE OR PIN FOUND  
R/W=RIGHT-OF-WAY  
D.B.=DEED OR DOCUMENT BOOK PG.=PAGE  
P.F.=PLAT FILE SL.=SLIDE  
THIS SURVEY IS OF AN EXISTING PARCEL OF LAND.  
THERE IS NO HORIZONTAL CONTROL WITHIN 2,000'  
THIS PROPERTY IS ZONED RI

The foregoing certificates of Clarence A. Jenkins,  
a professional Land Surveyor, and \_\_\_\_\_  
a Review Officer, are certified to be correct. This  
plat was presented for registration and recorded in  
this office in Plat File \_\_\_\_\_ at Slide \_\_\_\_\_, this  
the \_\_\_\_\_ day of \_\_\_\_\_, A.D. 2005 at  
\_\_\_\_\_ o'clock \_\_\_\_\_ m.

State of North Carolina  
County of \_\_\_\_\_  
I, \_\_\_\_\_, Review Officer of  
\_\_\_\_\_ CAUTION: This map or plat  
to which this certification is affixed meets all  
statutory requirements for recording.  
Review Officer Date

This survey is of an existing parcel of land and does not create a new street or change an existing street.

I, Clarence A. Jenkins P.L.S., certify that this  
plat was drawn under my supervision from an actual  
survey made under my supervision (deed description  
recorded in Book 403 Page 289); that the  
ratio of precision as calculated is 1 : 7900 ;  
that this plat was prepared in accordance with  
G.S. 47-30 as amended. Witness my original signature  
Registration number and seal this 22nd day of  
DECEMBER, A.D. 2005

Clarence A. Jenkins, P.L.S.  
Registration Number L-1291

I, Clarence A. Jenkins P.L.S. certify that this  
property is not located in the 100 year flood zone  
as per Flood Insurance Rate Maps.

Register of Deeds

Surveyed By  
**Clarence A. Jenkins, P.L.S.**  
# 3 Four Seasons Plaza, N. Broad Street  
Brevard N.C. 28712  
Tele. # 884-5880