



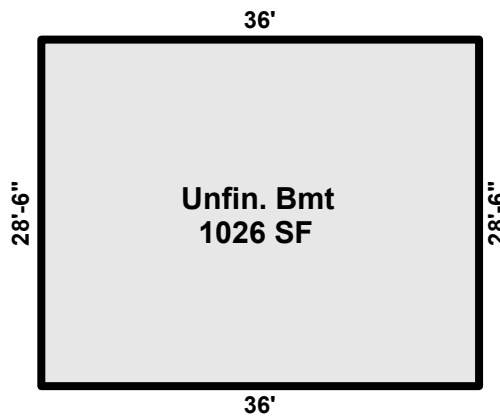

HEATED LIVING AREA

MAIN LEVEL = 1026 SF
SECOND LEVEL = 408 SF

TOTAL = **1434 SF**

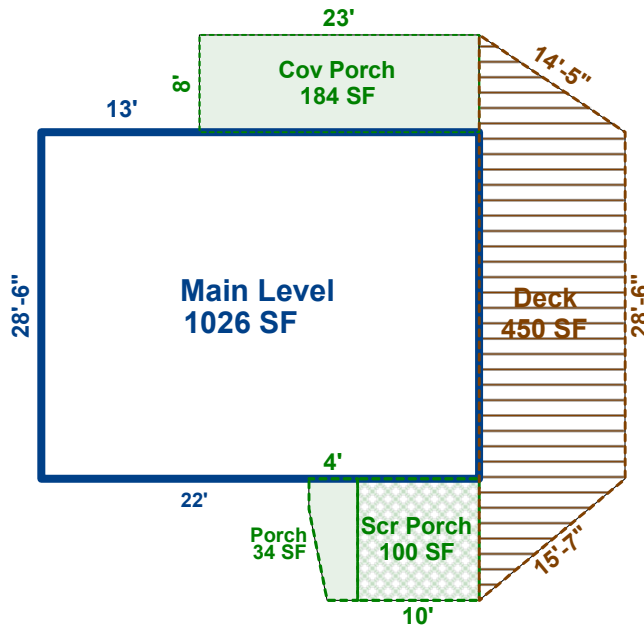

Prepared by Diane L. Jetton, HMS (828)553-0171. Interior sketches are for illustration purposes only.
Square foot calculations follow the ANSI Measurement Standards and the NCREC Guidelines.