


- LEGEND






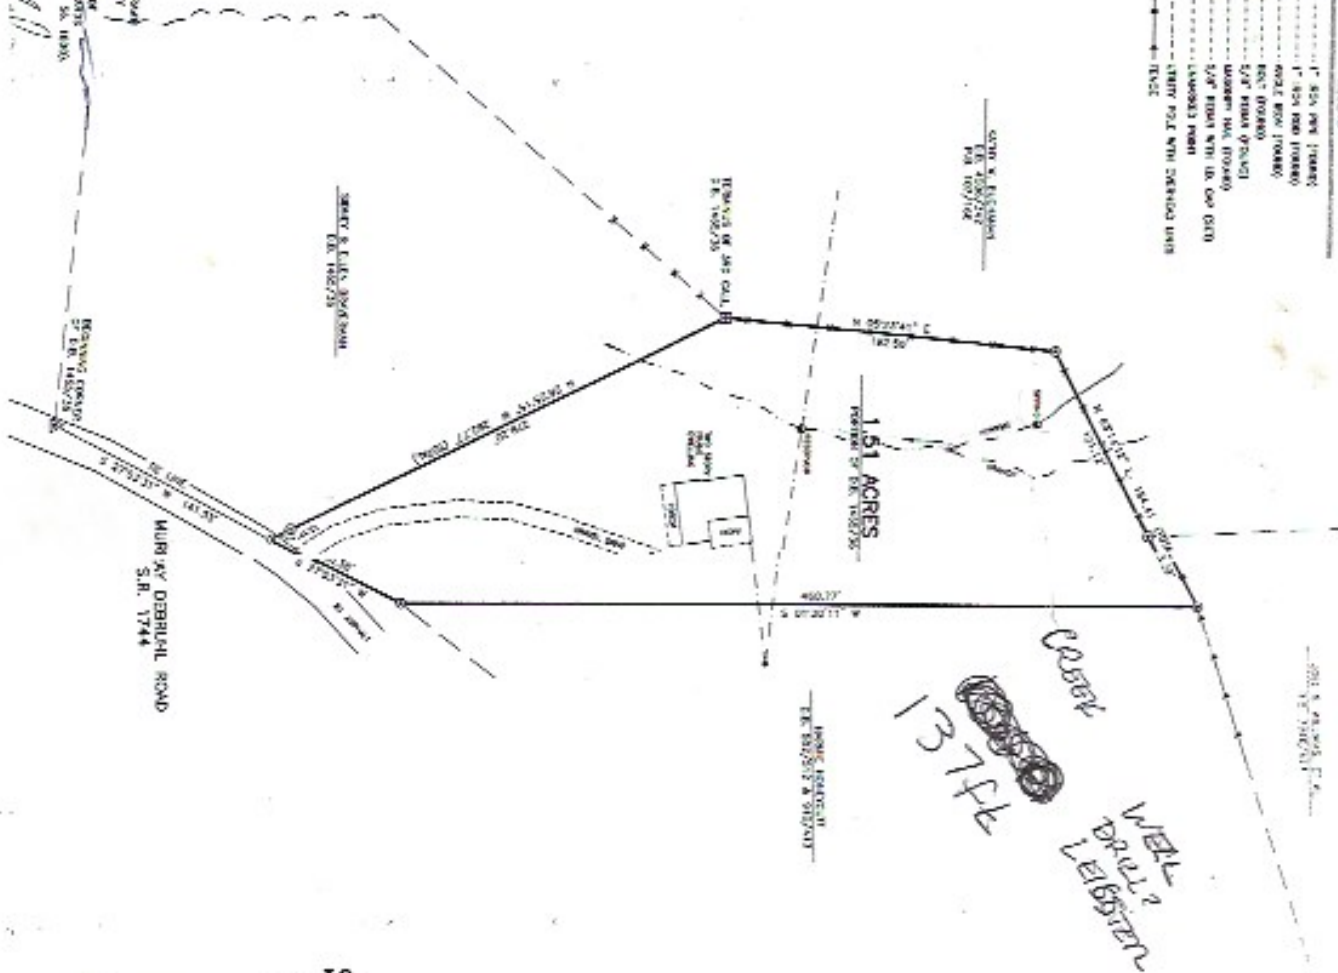

WELL DRILL? LEBSTER



NORTH - PLAT BOOK 107, PAGE 166

SIDNEY BRAVERMAN
AND
ELLEN BRAVERMAN

FRENCH BROAD TOWNSHIP
NORTH CAROLINA

McMAHAN & ASSOCIATES, P.A. (C-319)
P.O. BOX 1296
WEAVERVILLE, N.C. 28787
681-646-5654
FAX: 681-646-5141