PROPERTY OF

DOROTHY HOLLIS

Transylvania County
North Carolina

All bearings are magnetic
All distances are horizontal
Acreage calculated by D.M.D.
Error of closure calculated by latitudes and departures

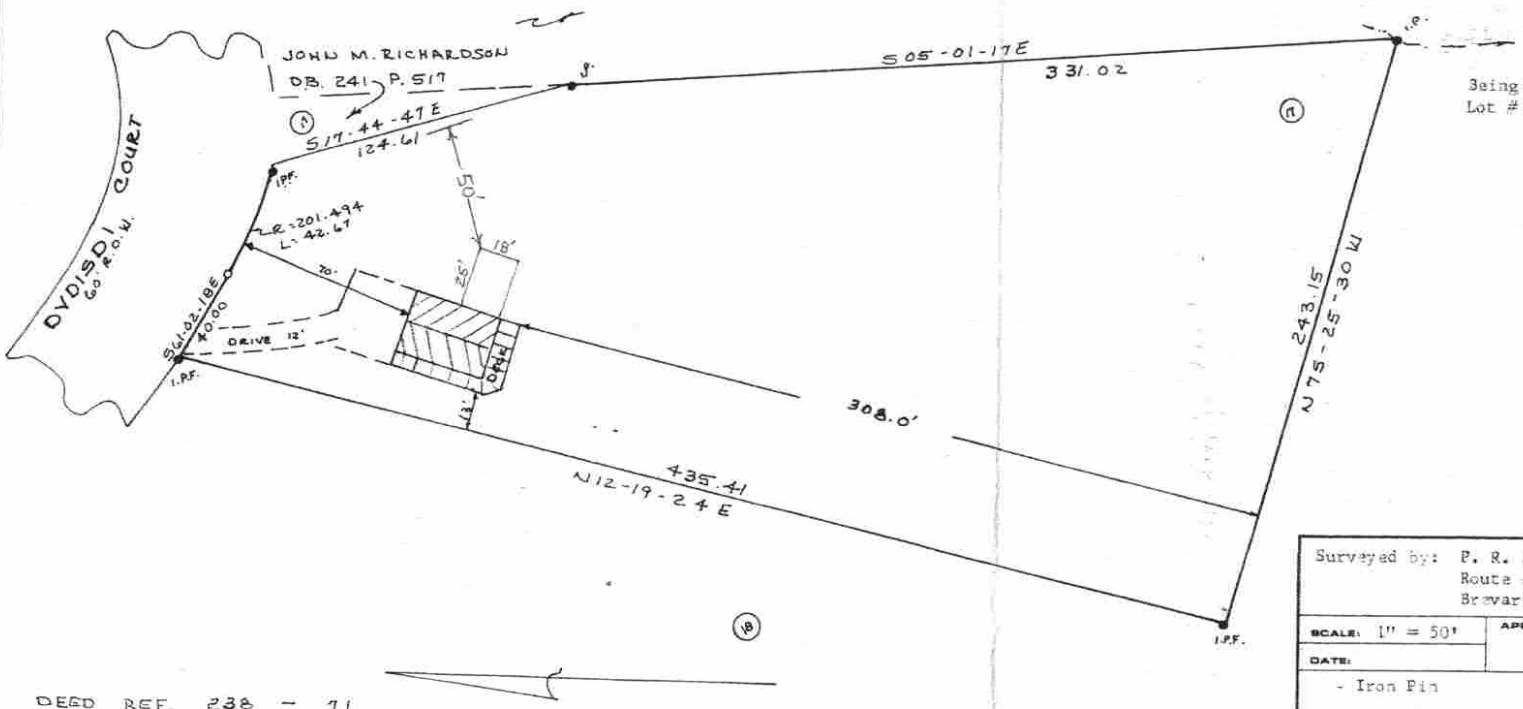

Being the major portion of
Lot # 17, Unit 23 of CONNESTEE FALLS DEVELOPMENT

P. R. Baxter
7-16-87

DEED REF. 238 - 71

Surveyed by: P. R. BAXTER, N. C. RLS 395
Route #1, Box 285
Brevard, North Carolina 28712

SCALE: 1" = 50'	APPROVED BY	DRAWN BY
DATE:		

- Iron Pin

25 0 50 100 150

DRAWING NUMBER

DIETZGEN NO. 1844F ADEPROOF MASTER FORM