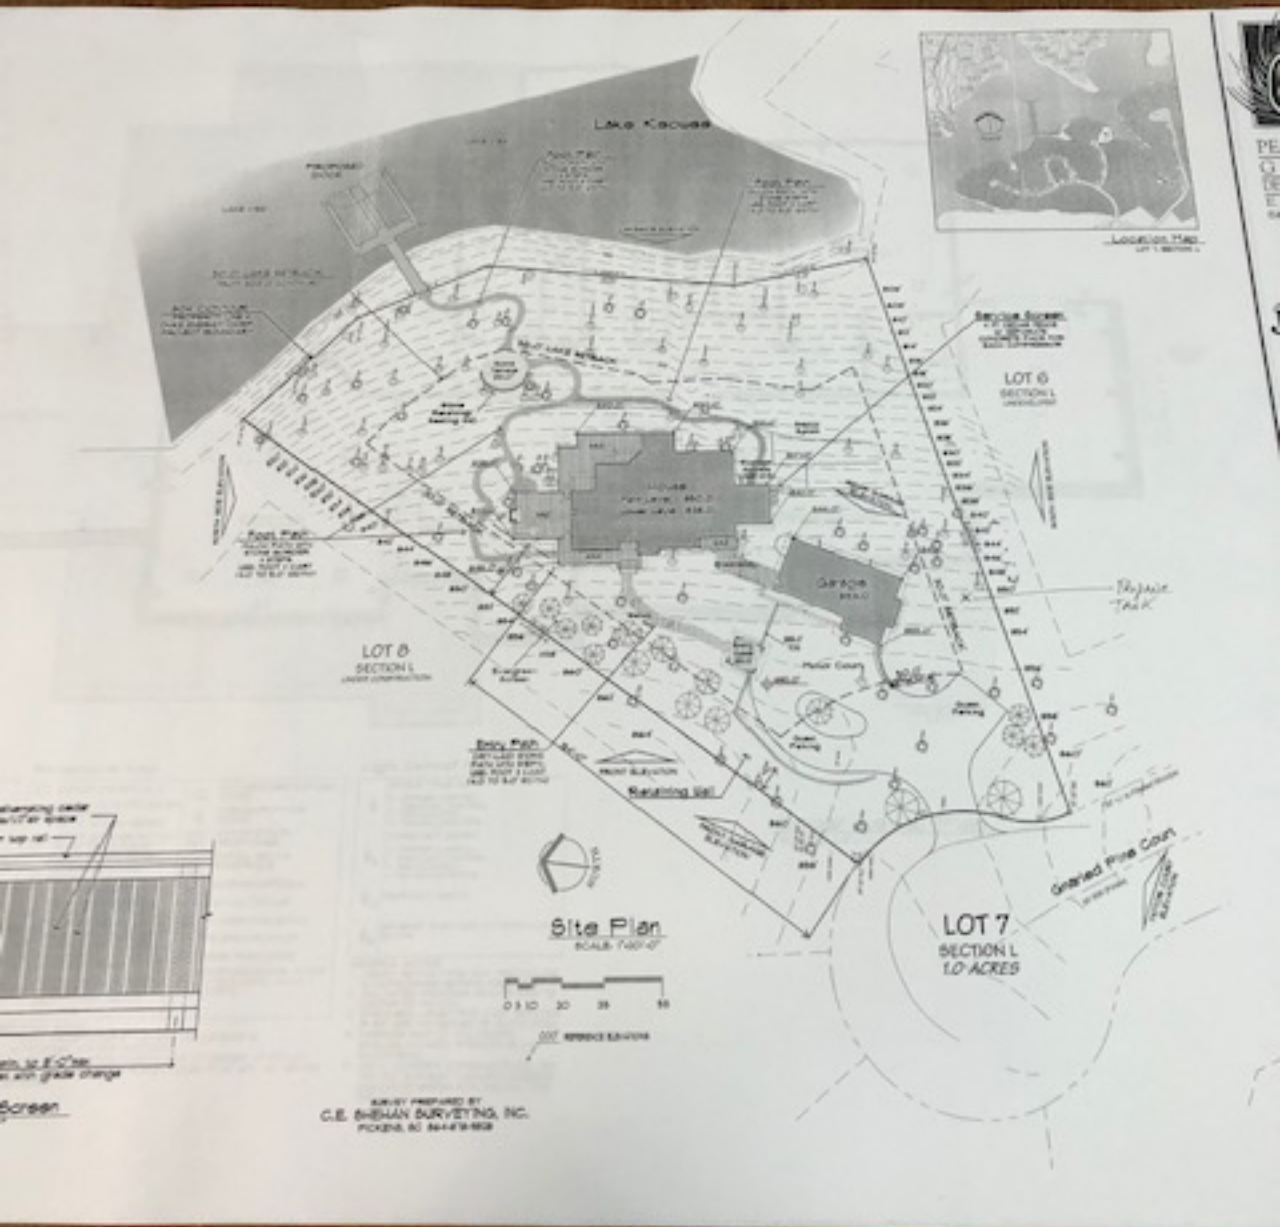
Lake Keowee
LOT 6
SECTION L
LOT 8
SECTION L
Gravel Pine Court
LOT 7
SECTION L
1.0 ACRES
Site Plan
SCALE: 1"=20'-0"
Location Map
Screen