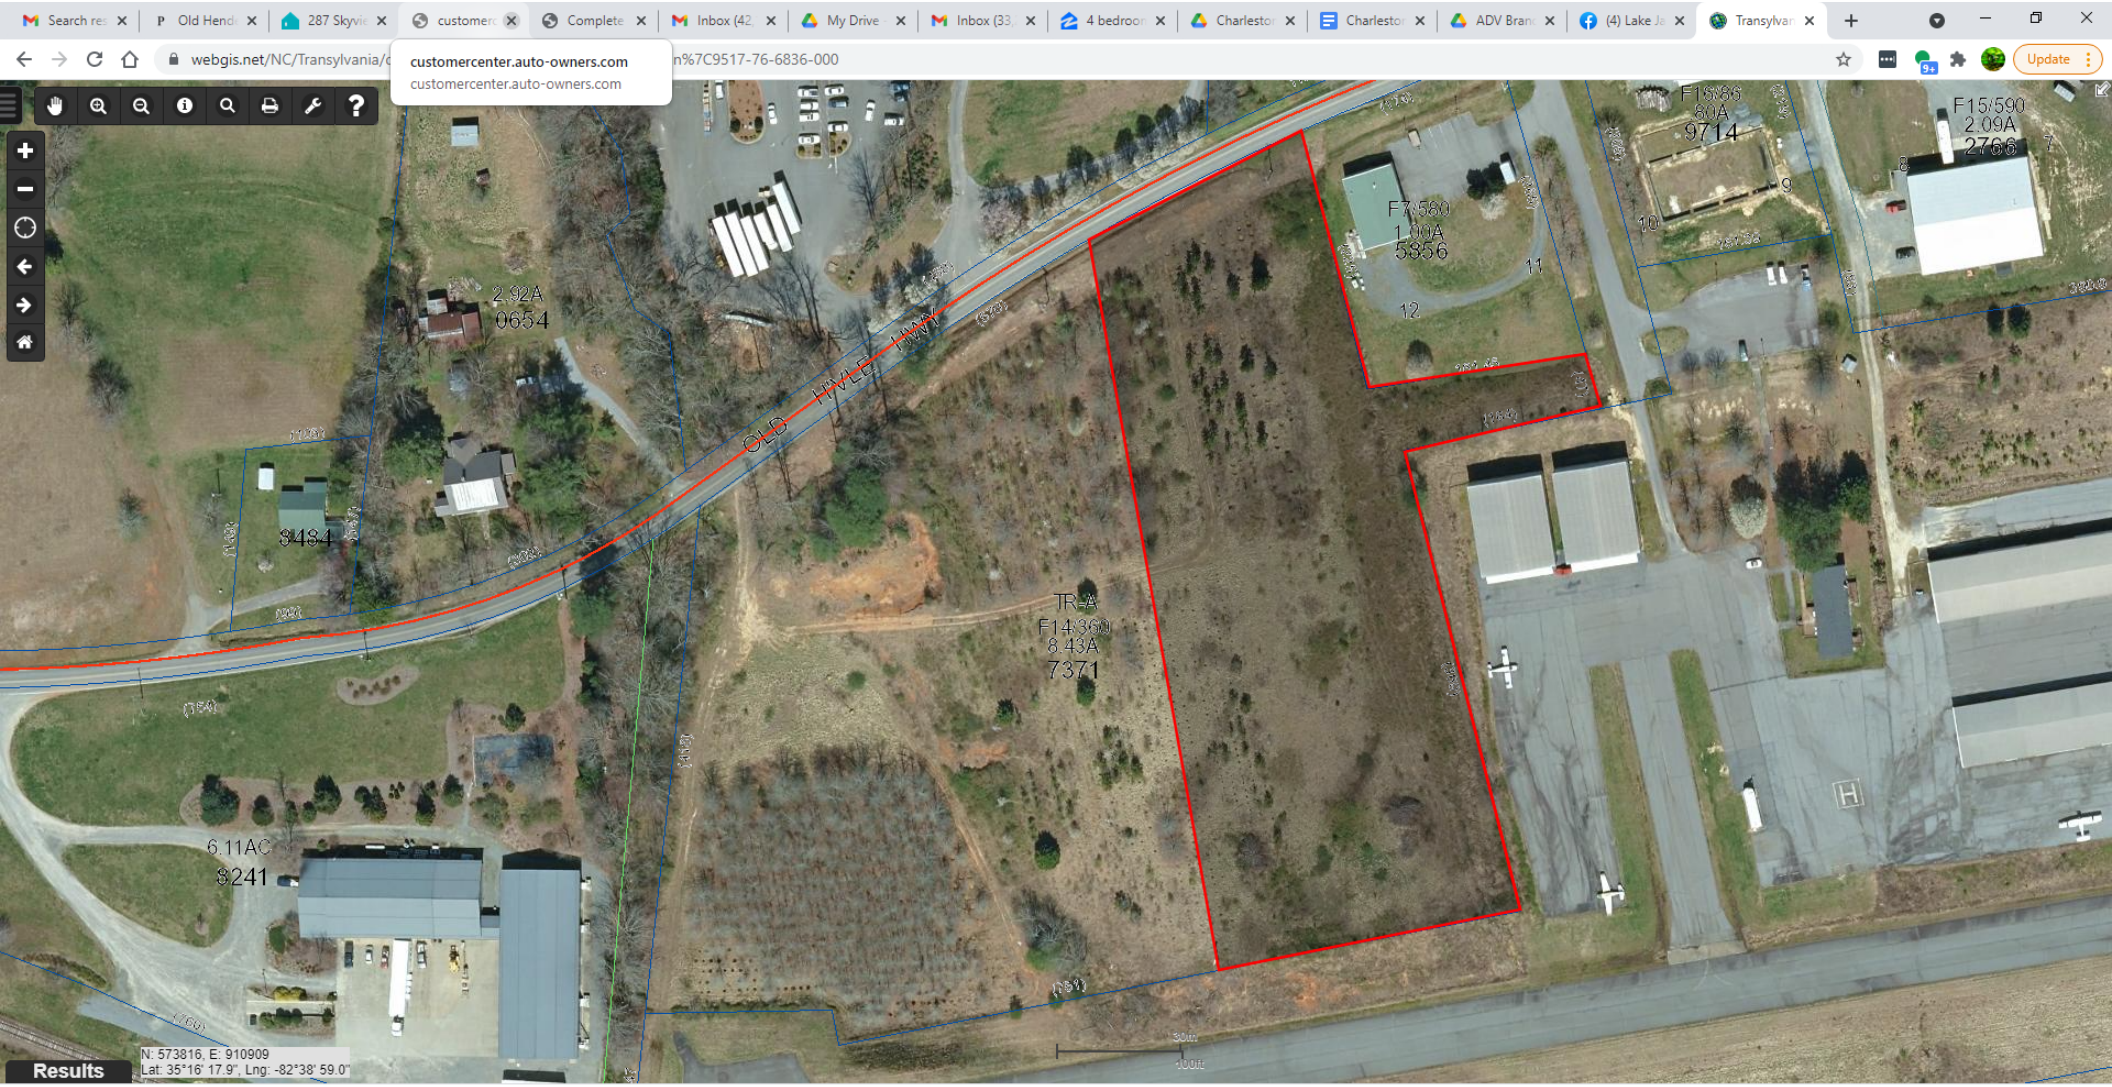

PXL_20210614_220....jpg PXL_20210614_222....jpg PXL_20210614_222....jpg PXL_20210614_222....jpg PXL_20210614_224....jpg PXL_20210614_224....jpg PXL_20210614_224....jpg Show all

Type here to search 68°F Partly sunny 9:00 AM 9/8/2021