TRANSYLVANIA COUNTY HEALTH DEPARTMENT

(Sewage Disposal System) Improvements Permit and Certificate of Completion
Sewage Treatment and Disposal Rules (10 NCAC 10 A .1934 - .1968)

See Attached

APPLICATION FOR AN IMPROVEMENTS PERMIT:

Owner Glenn Cannon Condos Address Brevard, N.C.

Location of Property: Country Club Rd - Glenn Cannon - At Condo site

Plat of Property: YES ☑ NO ☐

Type of Facility: House ☐ Mobile Home ☐ Business ☑ 21-2BR Unit Condos

Estimated Sewage Flow: 480 Gallons per day

Type of Water Supply: Drilled Well ☐ Spring ☐ Other ☑ Community

Signature of Owner or Authorized Agent: _____ Date: 9-30-82

IMPROVEMENTS PERMIT AND CERTIFICATE OF COMPLETION

OWNER-OCCUPANT Homeowners Assn

LOCATION Glenn Cannon

SUBDIVISION " "

LOT NO. #13 SECT. OR BLOCK NO. Colwell

BUILDING CONTRACTOR Bob ~~Colwell~~

ADDRESS Brevard, N.C.

SEPTIC TANK CONTRACTOR H. Houck

ADDRESS Brevard, NC

HOUSE ☐ MOBILE HOME ☐ BUSINESS ☐

NO. BEDROOMS 4 NO. BATHROOMS 4

SIZE OF SEPTIC TANK 1800 GALS. (Liquid) _____

MATERIAL: PRE-CAST ☑ BLOCK ☐ FIBERGLASS ☐

DISTRIBUTION BOX YES ☑ NO ☐

NO. OF LINES 4 WIDTH 3' FT. LENGTH 67' FT.

PERCOLATION TEST YES ☐ NO ☐

WATER SUPPLY: INDIVIDUAL ☐ PUBLIC ☑ Community

SITE CLASSIFICATION: SUITABLE ☐

PROV. SUITABLE ☐

UNSUITABLE ☐

IMPROVEMENTS PERMIT: DATE: 9-30-82

BY _____

CERTIFICATE OF COMPLETION: DATE: 9-9-82

BY _____ R.S.

NOTICE: System installed according to Rules and Regulations but not a guarantee that it will function satisfactorily for any given period of time.

COLOR CODE: White - Owner; Pink - Improvements Permit; Blue - Contractor; Yellow - Inspection Dept.; Green - Health Dept.

IMPROVEMENTS PERMIT SKETCH

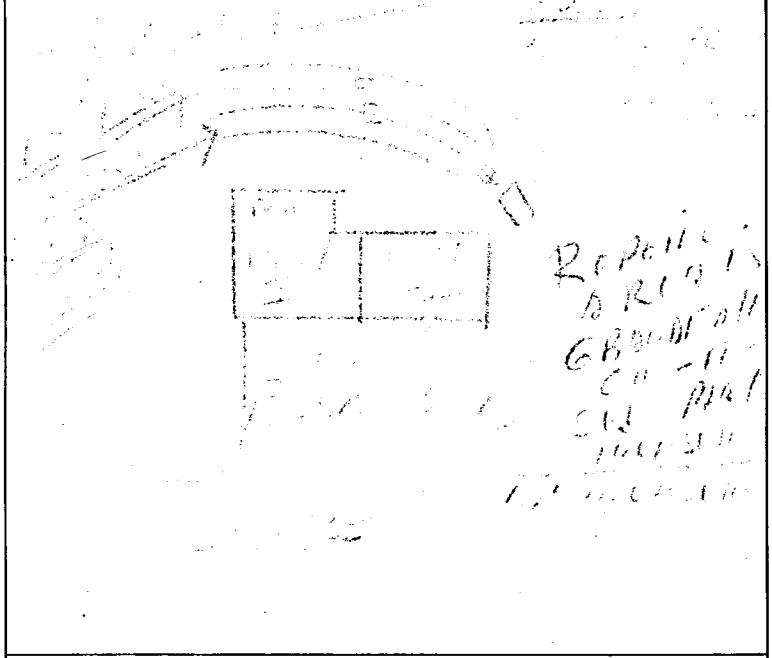
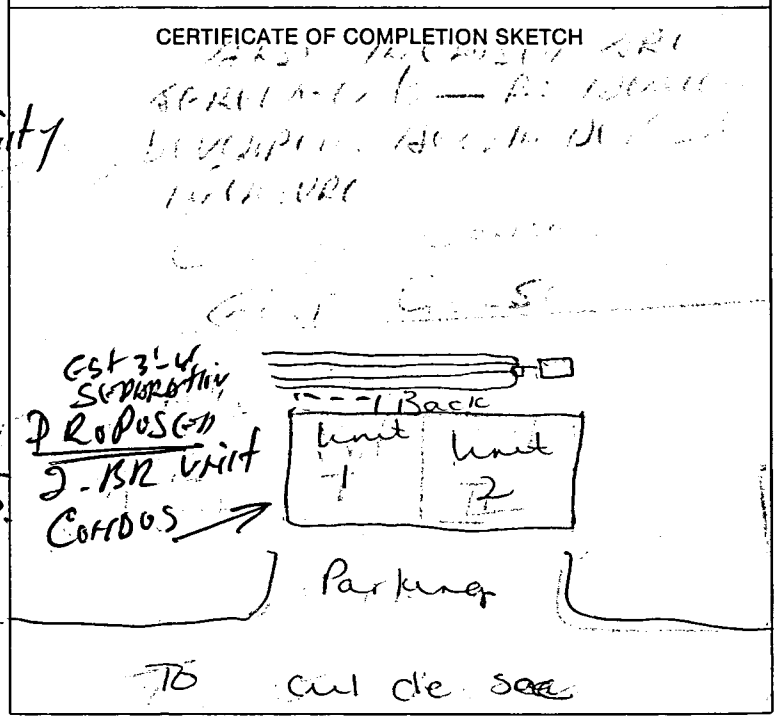
CERTIFICATE OF COMPLETION SKETCH