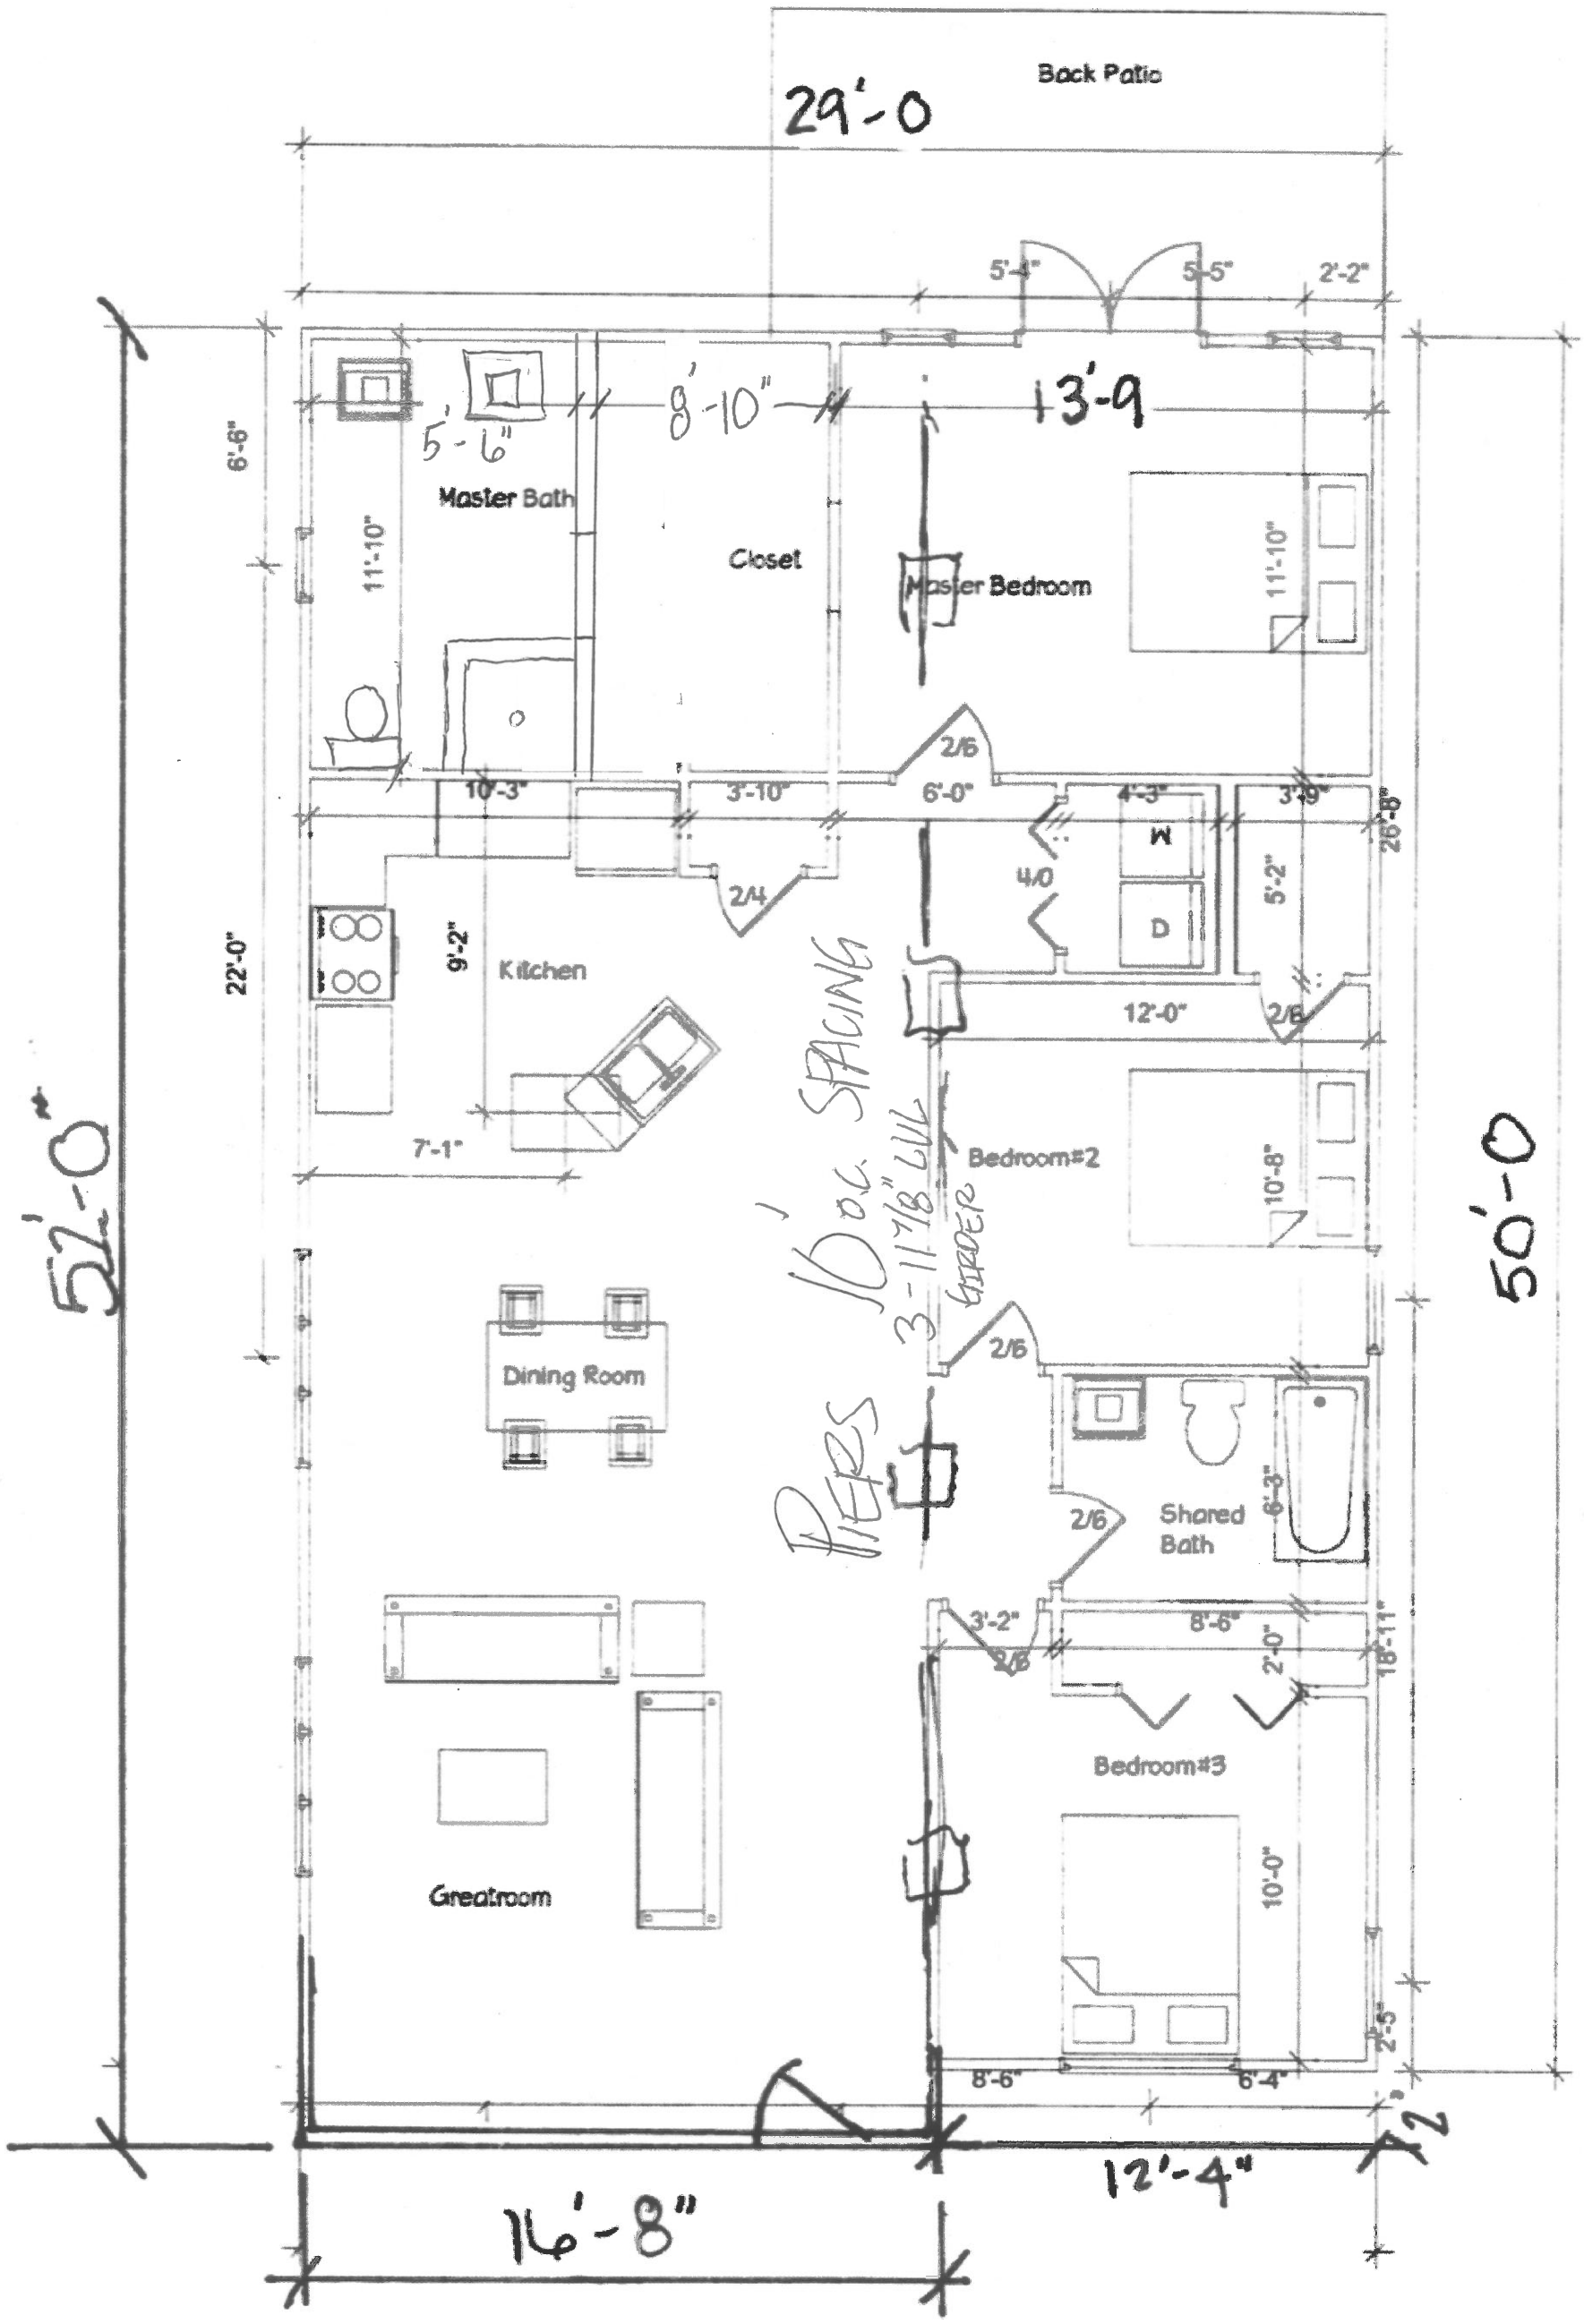
Back Patio
29'-0
5'-4"
5'-5"
2'-2"
13'-9
9'-10"
5'-6"
6'-6"
Master Bath
11'-10"
Closet
Master Bedroom
11'-10"
2/6
10'-3"
3'-10"
6'-0"
4'-3"
3'-9"
W
D
4/0
5'-2"
26'-8"
2/4
22'-0"
9'-2"
Kitchen
7'-1"
12'-0"
2/6
Bedroom#2
10'-8"
10 o.c. SPACING
3-11 7/8" LVL
GIRDER
Piers
2/6
Dining Room
Shared
Bath
6'-3"
2/6
3'-2"
8'-6"
2'-0"
18'-11"
2/6
Bedroom#3
Greatroom
10'-0"
2'-5"
8'-6"
6'-4"
12'-4"
52'-0"
50'-0"
16'-8"