SLIDE 7425

NORTH ARROW BASED ON DB. 759-774, HENDERSON COUNTY REGISTRY.

STATE OF NORTH CAROLINA

HENDERSON COUNTY
OFFICE OF REGISTER OF DEEDS
FILED FOR RECORD THIS THE 24 DAY OF JULY, 2008 AT 12:07 O'CLOCK P M
AND DULY REGISTERED IN SAID OFFICE
SLIDE 7425

Pedra W. Moler

REGISTER OF DEEDS
By: Nilla Blair, Deputy

NOTE:
THIS SURVEY REPRESENTS AN EXISTING TAX LOT PARCEL AND DOES NOT CREATE A NEW STREET OR CHANGE ANY EXISTING STREET, G.S. 47-30 (F)(11)(C)(1).

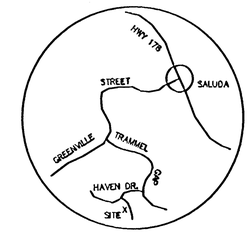

VICINITY MAP

NOTE:
THIS PARCEL IS SUBJECT TO ALL EASEMENTS AND RESTRICTIONS OF RECORD.

NO TITLE SEARCH PERFORMED BY BUTLER ASSOCIATES.

State of North Carolina
County of Henderson

I, DENNIS FREESMAN, Review Officer of Henderson County, certify that the map or plat to which this certification is affixed meets all statutory requirements for recording.

Dennis Freesman
Review Officer

7/24/2008
Date

LINE	BEARING	DISTANCE
L1	S 54°50'09" E	25.97'
L2	S 41°11'32" E	27.02'
L3	S 29°43'30" E	40.43'
L4	S 17°51'20" E	73.40'

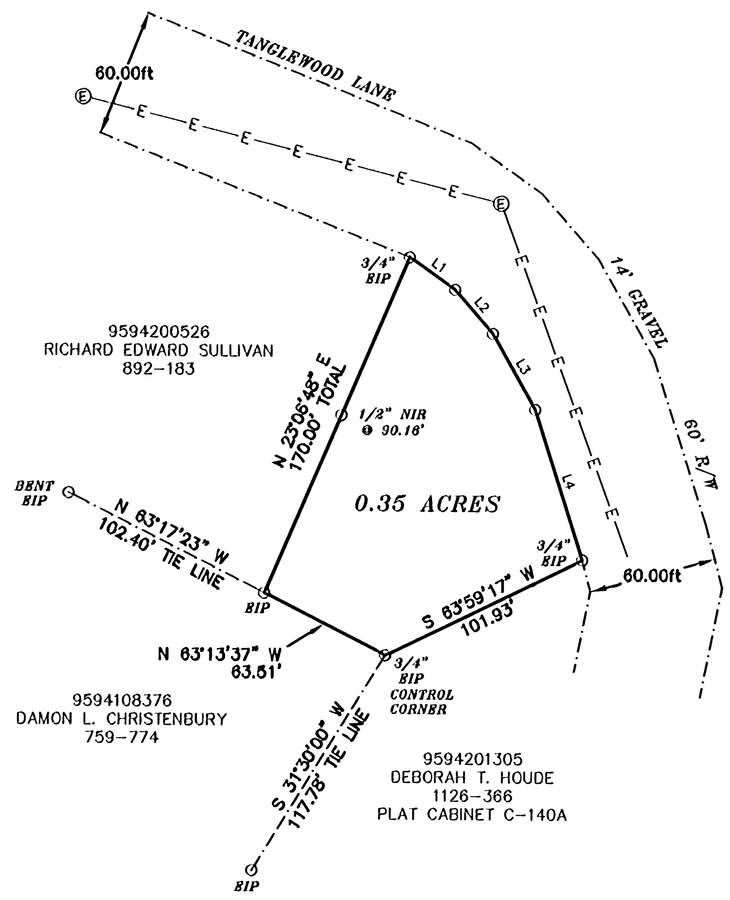

STATE OF NORTH CAROLINA, POLK COUNTY, I [signature] CERTIFY THAT THIS MAP WAS (~~DRAWN BY ME~~)/(DRAWN UNDER MY SUPERVISION) FROM (~~AN ACTUAL SURVEY BY ME~~)/(AN ACTUAL SURVEY MADE UNDER MY SUPERVISION)-DEED DESCRIPTION RECORDED IN BOOK 1352 PAGE 78 BOOK_____PAGE_____;ETC...; THAT THE RATIO OF PRECISION AS CALCULATED BY LATITUDES AND DEPARTURES IS 1/10,000; THAT THE BOUNDARIES NOT SURVEYED ARE SHOWN AS BROKEN LINES PLOTTED FROM INFORMATION FOUND IN BOOK_____PAGE_____; THAT THIS MAP WAS PREPARED IN ACCORDANCE WITH G.S.47-30 AS AMENDED. WITNESS MY HAND AND SEAL THIS 24th DAY OF July, 20 08

[signature] L-3033
SURVEYOR REG. NO.

NORTH CAROLINA PROFESSIONAL SEAL L-3033 LAND SURVEYOR ROBERT BARRY BUTLER

LEGEND:
NIR - NEW IRON ROD
EIP - EXISTING IRON PIPE
Ⓔ - ELECTRICAL POLE

NOTE:
THIS PROPERTY IS NOT LOCATED IN A SPECIAL FLOOD HAZARD AS DETERMINED BY THE DEPARTMENT OF HOUSING AND URBAN DEVELOPMENT.

SURVEY FOR
DEBORAH T. HOUDE
GREEN RIVER TWP., HENDERSON CO., NO. CAR.
LEGAL REFERENCE: DB. 1352/78

MAY 28, 2008

BUTLER ASSOCIATES
10 MAPLE STREET
TRYON, NC 28782
828-859-5390

TAX PARCEL:
9594200488

GRAPHIC SCALE 1" = 50'
0' 50' 100' 150'

RATIO OF PRECISION: 1:10,000
D-145-47

11534B