


984 EAGLE LAKE DR., BREVARD, NC 28712

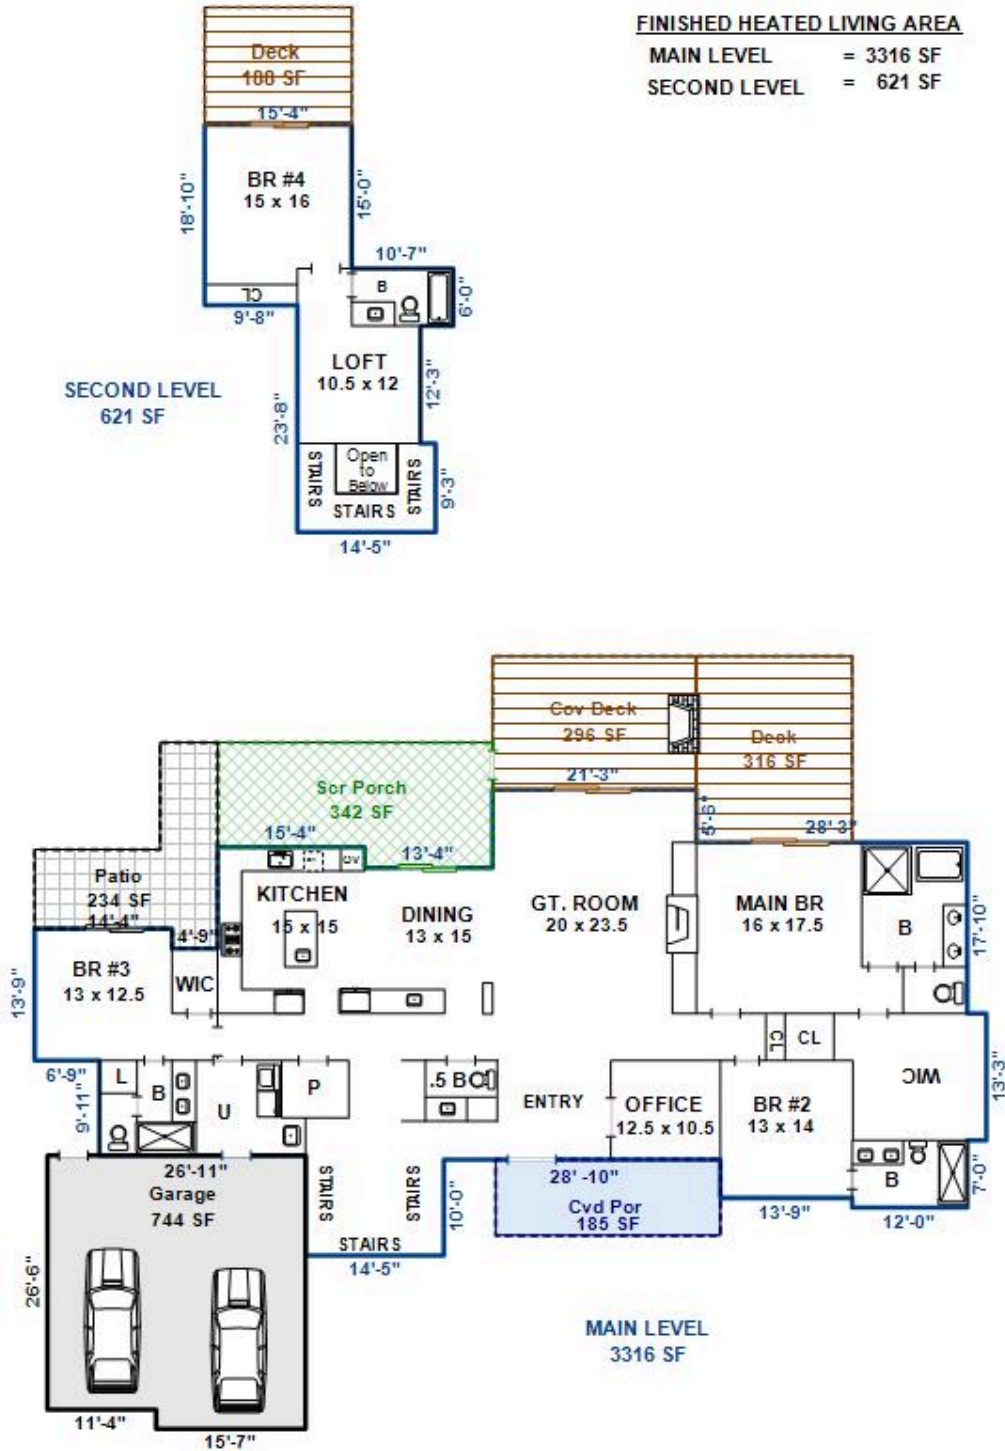

Interior sketches are for illustration purposes only.
Prepared by Diane L. Jetton, HMS (828)553-0171; dlj@pobox.com