
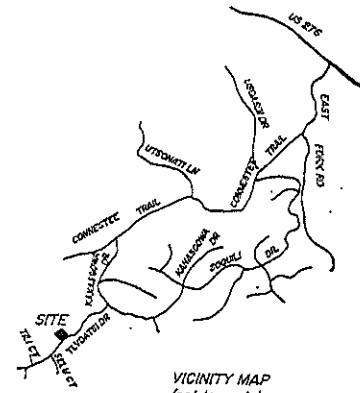


File 11 Slide 1003

NORTH FROM P.S. 4 PG. 814

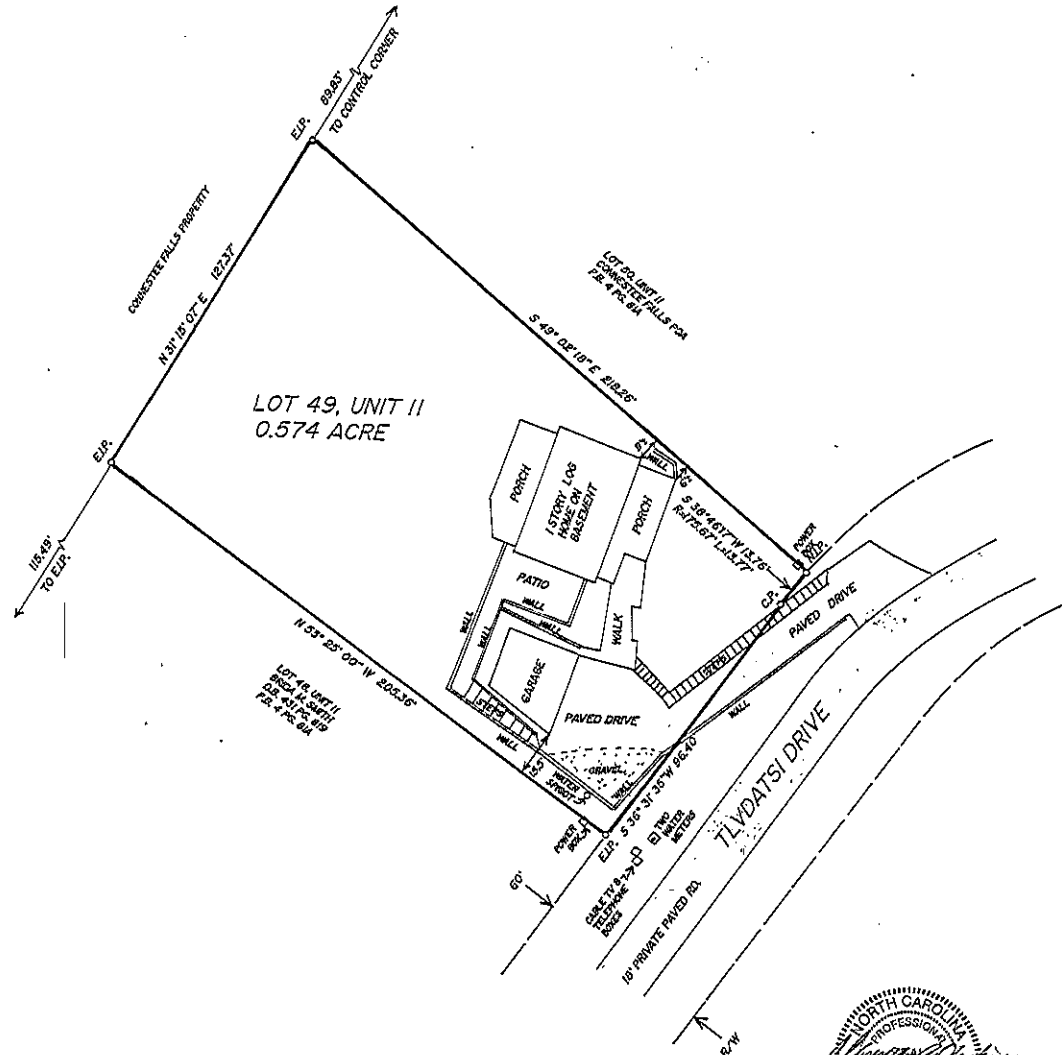

VICINITY MAP
(not to scale)

2006010294
 TRANSLATED TO NC PER 221.00
 PREPARED & ASSURED
 12-15-2006 11:26:46 AM
 CINDY N OROCK
 REGISTERED SURVEYOR
 BY: TERESA D MORTON
 SURVEY REGISTERED OF DEEDS
 PF 11
 PG:1003-1003



246 TLVDATSI DRIVE
 SURVEY FOR:
SAUNDRA RIGGS
 LOT 49, UNIT II OF CONNETTEE FALLS
 DUNNS ROCK TOWNSHIP, TRANSYLVANIA COUNTY, N.C.
 DEED REFERENCE: DOCUMENT BOOK 110 PAGE 40
 PLAT REFERENCE: PLAT BOOK 4 PAGE 814
 TAX PIN: 0382-05-1240-000

0 30 60
 SCALE: 1" = 30' DATE: NOV. 29, 2006

LEGEND & NOTES:
 E.I.P. = EXISTING IRON PIPE OR PIN FOUND
 N.I.P. = NEW IRON PIN SET
 C.P. = CALCULATED UNMARKED POINT
 R/W = RIGHT-OF-WAY
 D.B. = DEED OR DOCUMENT BOOK PG. = PAGE
 P.B. = PLAT BOOK PG. = PAGE
 THIS SURVEY IS OF AN EXISTING PARCEL OF LAND.
 THERE IS NO HORIZONTAL CONTROL WITHIN 2,000'

I, Clarence A. Jenkins P.L.S., certify that this property is not located in the 100 year flood zone as per Flood Insurance Rate Maps.

The foregoing certificates of Clarence A. Jenkins, a professional Land Surveyor, and _____, a Review Officer, are certified to be correct. This plat was presented for registration and recoded in this office in Plat File _____ at Slide _____, this the _____ day of _____, A.D. 2006 at _____ o'clock _____ m.

 Register of Deeds

State of North Carolina
 County of _____
 I, _____, Review Officer of _____ County, certify that the map or plat to which this certification is affixed meets all statutory requirements for recording.

 Review Officer Date

This survey is of an existing parcel of land and does not create a new street or change an existing street.

I, Clarence A. Jenkins P.L.S., certify that this plat was drawn under my supervision from an actual survey made under my supervision (dead description recorded in Book 110 Page 40); that the ratio of precision as calculated is 1 : 1,000; that this plat was prepared in accordance with G.S. 47-30 as amended. Witness my original signature Registration number and seal this _____ day of _____, A.D. 2006
 Clarence A. Jenkins, P.L.S.
 Registration Number L-1291