TRANSYLVANIA COUNTY HEALTH DEPARTMENT

Sewage Disposal System Improvements Permit and Certificate of Completion Sewage Treatment and Disposal Rules (Article 11 of Chapter 130A of the General Statutes of North Carolina)

8572-87-0893-000

Date: 8/28/90 Receipt No.: 1702

Owner/Agent: Mrs. La Donna Hazlett Phone No.: ~~884-3350~~ 883-3350

Address: 43 Dvdisdi Court, Connestee Falls, NC

Location of Property: go in main entrance, stay on turn L at Connestee Trail, down UGUGU, L at bottom of hill - ~~in ranch section of~~ Connestee on Dvdisdi Ct which is 2nd L off Ugugu, go to end of culdesac

Subdivision: Connestee Falls Lot Number: 23 Section: 23 Plat of Property: Yes ☒ No ☐

Type of Facility: House ☒ Mobile Home ☐ Business ☐ Basement Yes ☒ No ☐ Basement Plumbing Yes ☒ No ☐

Number of Bedrooms: 3 Number of Bathrooms: 3 Estimated Sewage Flow: 360 gpd

Lot Size: 1.67 acres Easements, Right-of-Ways, etc.: electrical Date Lot Recorded: 6/8/90

Type of Water Supply: Individual—Drilled Well ☐ Spring ☐; Public/Community ☒

Signature/Authorized Agent: Richard W. Hazlett Date: 9/4/90

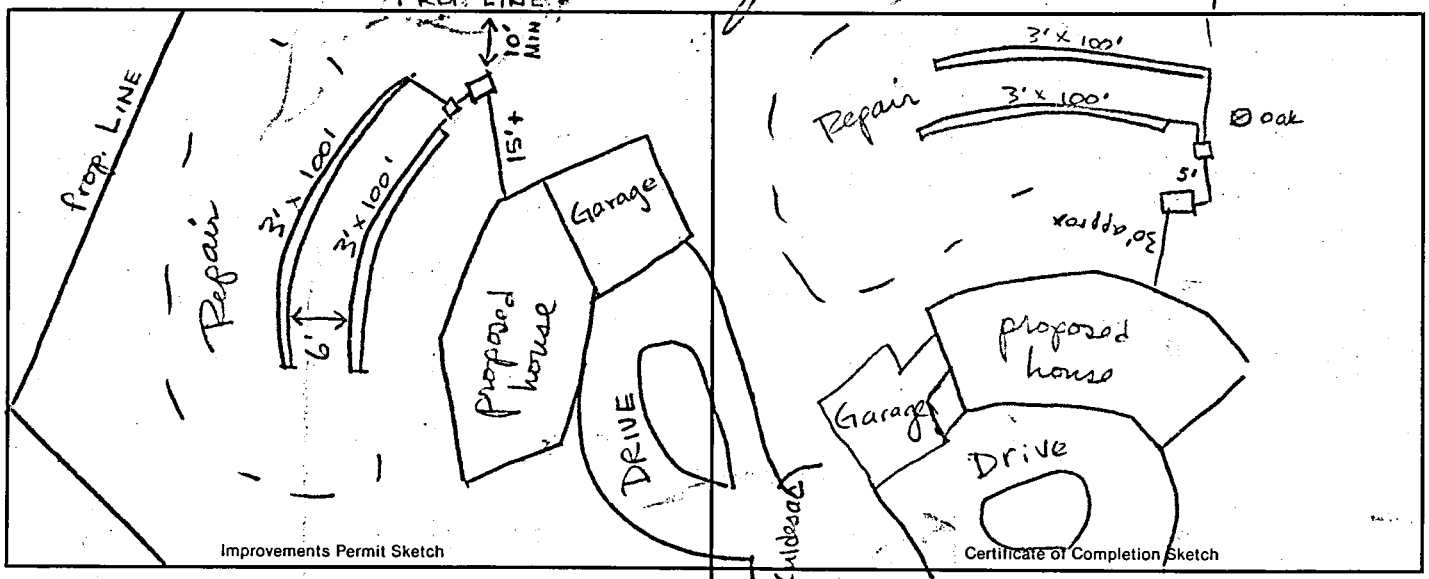

Nitrification trenches shall be installed on level grade with contour. Stepdowns permitted only when indicated.

New System ☒ Repair ☐ Addition ☐

Size of Tank: 1000 Application Rate: .6 gpd/ft²

No. of Lines: 2 Width: 3' Linear Ft.: 100'

Square Ft.: 600 Maximum Trench Depth: 18-22" on low side of trenches

I understand and agree to install the septic tank system as specified on this Improvements Permit. Permit is void if any changes are made without consent of the Health Department Representative and/or if any false information is supplied in making Improvements Permit.

Richard W. Hazlett 9/4/90
Signature/Authorized Agent Date

Norma R. Nash, RS 9/4/90
By Date

Building Contractor: ——

System Installed by: Jerry Whitmire

This is to certify that system is installed according to Rules and Regulations but is not a guarantee that it will function satisfactorily for any given period of time.

Norma R. Nash, RS 9/20/90
By Date

EXISTING SYSTEM: Addition/Remodeling ☐ Relocation ☐

System functioning properly at time of inspection and is approved for proposed additions/renovations.

By Date

Color Codes: Health Dept.—Green; Owner—White; Contractor—Canary; Improvements Permit—Pink

* If tank is greater than 30" underground, a riser lid shall be placed over it extending 6" above grade.

* Septic tank shall be installed prior to start of house foundation.