COUNTY PIN# ____ - ____ APPLICATION# [redacted]

RUTHERFORD-POLK-McDOWELL DISTRICT HEALTH DEPARTMENT
OPERATION PERMIT

(Permit subject to revocation if site plans or intended use changes)

- [x] New
- [ ] Repair
- [ ] Addition
- [ ] Re-evaluation

R-P-M

Owner: Burdette, Joseph County: Polk

(State Rd. #-Street Name - Development Name - Lot#) Community/Area:

Lot 88 Piney Mtn. Ph IV Sect I Lot 88

Type Facility: 3 br. Type System: III, LTH Tank Serial # K-1000 SIB A1

Trenches: 2 Trench Lengths: 70'; 70' Trench Width: 3ft Design Flow: 360 gpd

Type Water Supply: Public System Installed by: Gary Halford

Comments: Tank w/ filter < 1" dep.

Site Plan with System Details Below (Not drawn to scale) Lot Size: ____ Acres

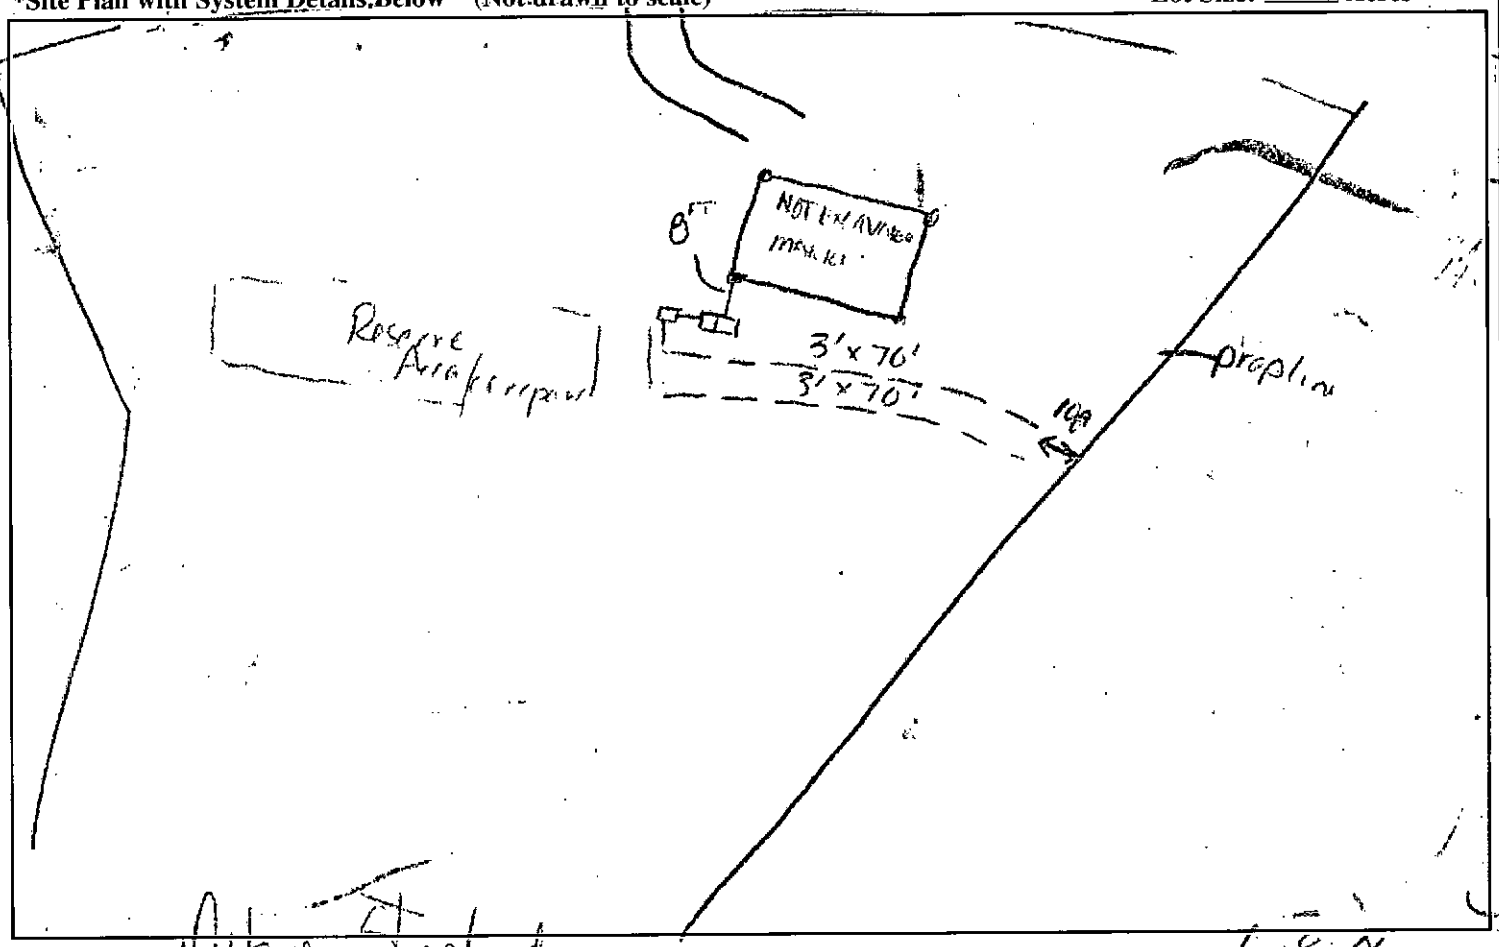


Environmental Health Specialist

COMPLETION OF THIS OPERATION PERMIT ALLOWS THE SYSTEM TO BE PLACED INTO USE. PROPER CARE OF YOUR SEPTIC SYSTEM REQUIRES MANAGEMENT AS WELL AS PERIODIC MAINTENANCE.

OPERATION AND MAINTENANCE RECOMMENDATIONS:

1. The drainfield does not have unlimited capacity. Try to limit the volume of your wastewater and repair any dripping faucets or toilets. Be sure that the water from the roof gutters, foundation drains, and ground surface does not flow over the system.
2. Do not add materials such as hygiene products, cigarette butts, coffee grinds, disposable diapers, cooking oils or grease to the septic tank system and restrict the use of garbage disposals.
3. Maintain a grass vegetative over the drainfield to prevent soil erosion.
4. Avoid driveway construction or other over the system and repair area and keep automobiles and heavy equipment off the septic tank system. Do not cover with fill dirt.
5. Don't wait until your drainfield fails to have your tank pumped, by then the drainfield may be ruined. Have solids pumped out of the tank as needed, usually every 3-5 years.

Form # LP-699

OWNER: Burdette, Joseph

PIN # [redacted] Piney Mtn. Sect. I, Lot 88

COUNTY PIN# ____ - _____ APPLICATION# 010216

RUTHERFORD-POLK-McDOWELL DISTRICT HEALTH DEPARTMENT
OPERATION PERMIT

(Permit subject to revocation if site plans or intended use changes)

- [x] New
- [ ] Repair
- [ ] Addition
- [ ] Re-evaluation

R-P-M

Owner: Burdette, Joseph County: Polk

(State Rd. #-Street Name - Development Name - Lot#) Community/Area:

Lot 88 Piney Mtn. Ph IV Sct I Lot 88

Type Facility: 3 br. Type System: III EZH Tank Serial # K-1000 STB A1

Trenches: 2 Trench Lengths: 70'; 70' Trench Width: 3ft Design Flow: 360 gpd

Type Water Supply: Public System Installed by: Gary Holford

Comments: Tank w/ filter < 6" deep.

Site Plan with System Details Below (Not drawn to scale) Lot Size: ____ Acres

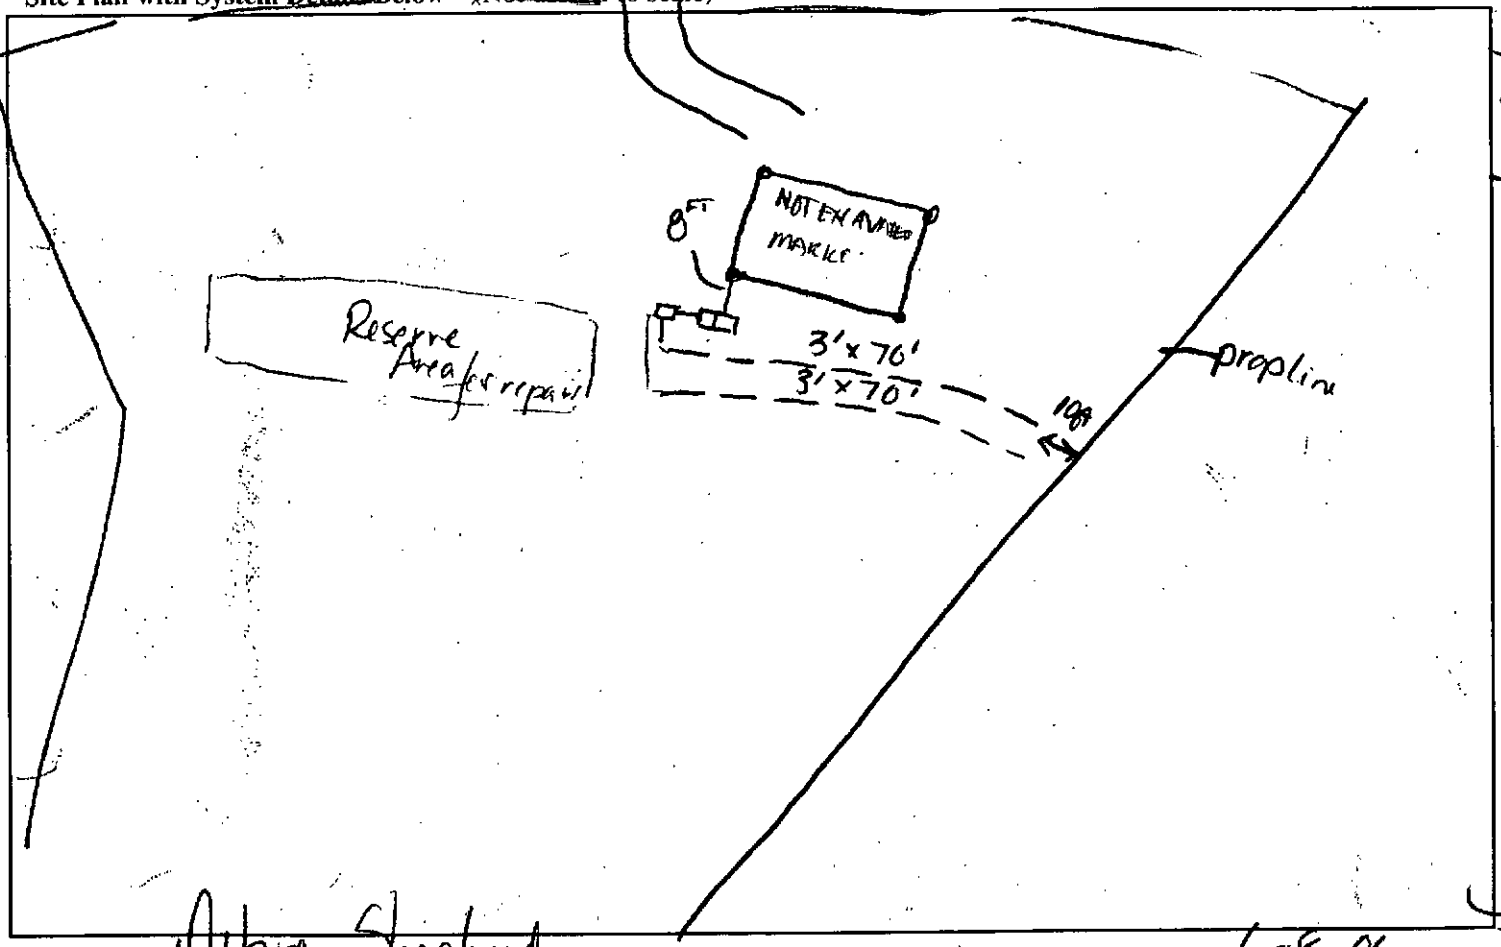

Issued by: Nikra Shepherd, R.S. Date 6-8-06

Environmental Health Specialist

COMPLETION OF THIS OPERATION PERMIT ALLOWS THE SYSTEM TO BE PLACED INTO USE. PROPER CARE OF YOUR SEPTIC SYSTEM REQUIRES MANAGEMENT AS WELL AS PERIODIC MAINTENANCE.

OPERATION AND MAINTENANCE RECOMMENDATIONS:

1. The drainfield does not have unlimited capacity. Try to limit the volume of your wastewater and repair any dripping faucets or toilets. Be sure that the water from the roof gutters, foundation drains, and ground surface does not flow over the system.
2. Do not add materials such as hygiene products, cigarette butts, coffee grinds, disposable diapers, cooking oils or grease to the septic tank system and restrict the use of garbage disposals.
3. Maintain a grass vegetative over the drainfield to prevent soil erosion.
4. Avoid driveway construction or other over the system and repair area and keep automobiles and heavy equipment off the septic tank system. Do not cover with fill dirt.
5. Don't wait until your drainfield fails to have your tank pumped, by then the drainfield may be ruined. Have solids pumped out of the tank as needed, usually every 3-5 years.

Form # LP-699

OWNER: Burdette, Joseph

PIN # Piney Mtn Ph IV Sct I Lot 88

☑ New
☐ Repair
☐ Addition

APPLICATION # 010216

Rutherford-Polk-McDowell District Health Department
Improvement Permit (Expiration Date) 10-2-06

(Permit subject to revocation if site plans or intended use change)

Owner or Legal Agent: Burdette, Joseph County: Polk

Mailing Address:

Street/Develop. Name/Lot # Piney Mtn. Ph III, Sect. I, Lot 88

Home Phone #: Work Phone #:

Directions to property - State Road No. and Name: From Saluda, Holbert Cove Rd. 6 miles to (L) on Piney Gate - go to end, then (L) on Wesley Lane. 400ft. on (L) past Valley Lane.

Type of water supply: ☐ Private well ☑ Public or community water system ☐ Spring gravelless

Type of Facility: 3br. home no basement Type of Wastewater System: III 25% reduction

Design Waste Flow: 360 G.P.D. L.T.A.R. 0.8 gps Tank Capacity (min.) 1,000 gallons

No. of Trenches 2 Trench Length 90 Ft. Trench Width 3 Ft Max. Trench Depth 24 In.

Conditions/Comments: Keep trenches on contour. Stay 5' from house 10ft. from prop lines w/ system.

* NOT DRAWN TO SCALE * *SITE PLAN WITH SYSTEM DETAILS* LOT SIZE

DA NS
DR - reevaluated

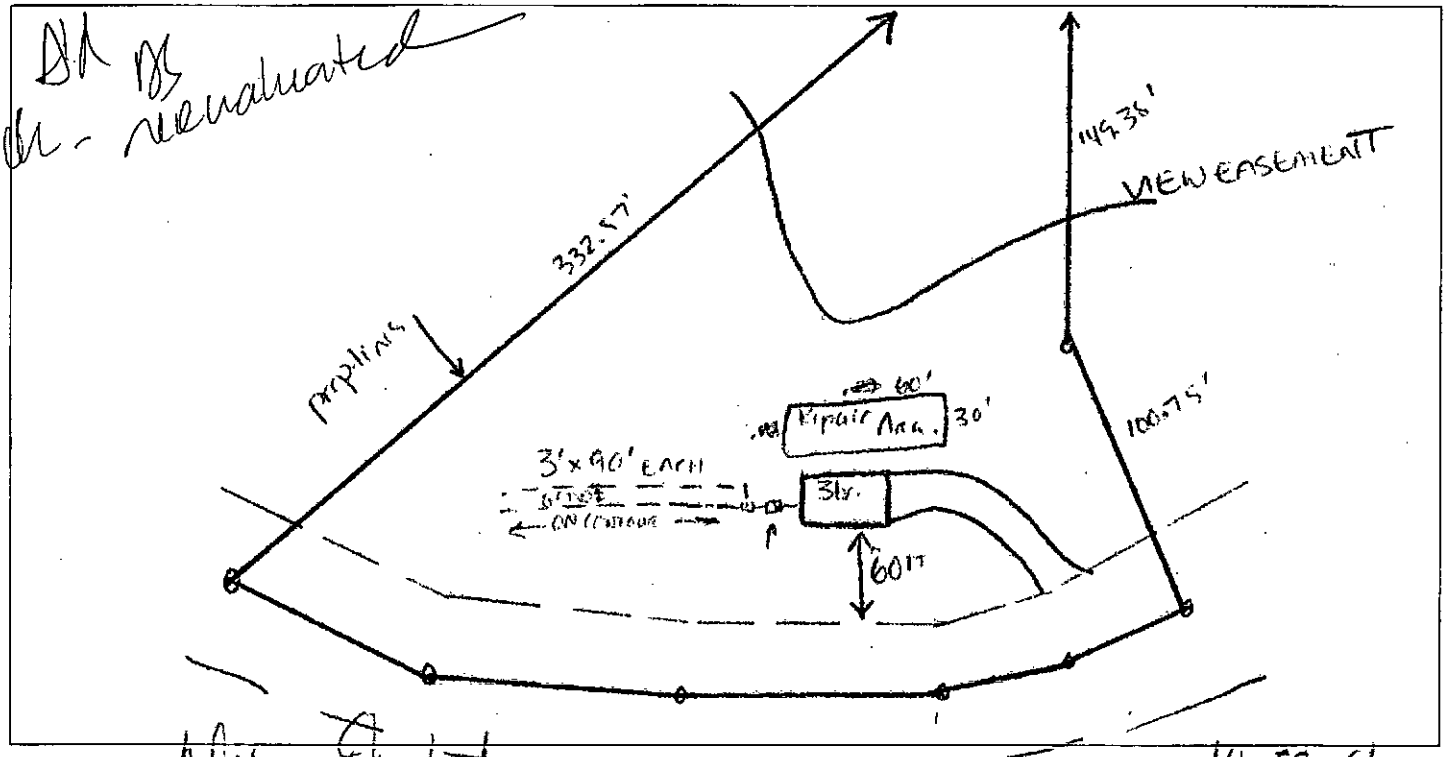

Issued By: Alisha Hurst Date: 10-02-01
Environmental Health Specialist

AUTHORIZATION FOR WASTEWATER SYSTEM CONSTRUCTION
(VOID AFTER 5 YEARS)

Construction of the wastewater system for the improvement permit indicated above is hereby authorized. The wastewater system described in the improvement permit has been designed and can be installed and operated in compliance with Article 11 of Chapter 130A of the General Statutes of N. C. and Rules adopted pursuant to this article. Any alteration of the site or soil conditions, changes to the proposed facility to be served, or submission of false information may subject the permit and authorization to suspension or revocation.

Issued By: Alisha Hurst Date: 10-02-01
Environmental Health Specialist

LP-513

WHITE - OWNER/AGENT PINK - BLDG. INSPECTOR MANILLA - HEALTH DEPT.

Owner or Legal Agent: Burdette, Joseph Piney Mtn. Ph III Sect I, Lot 88

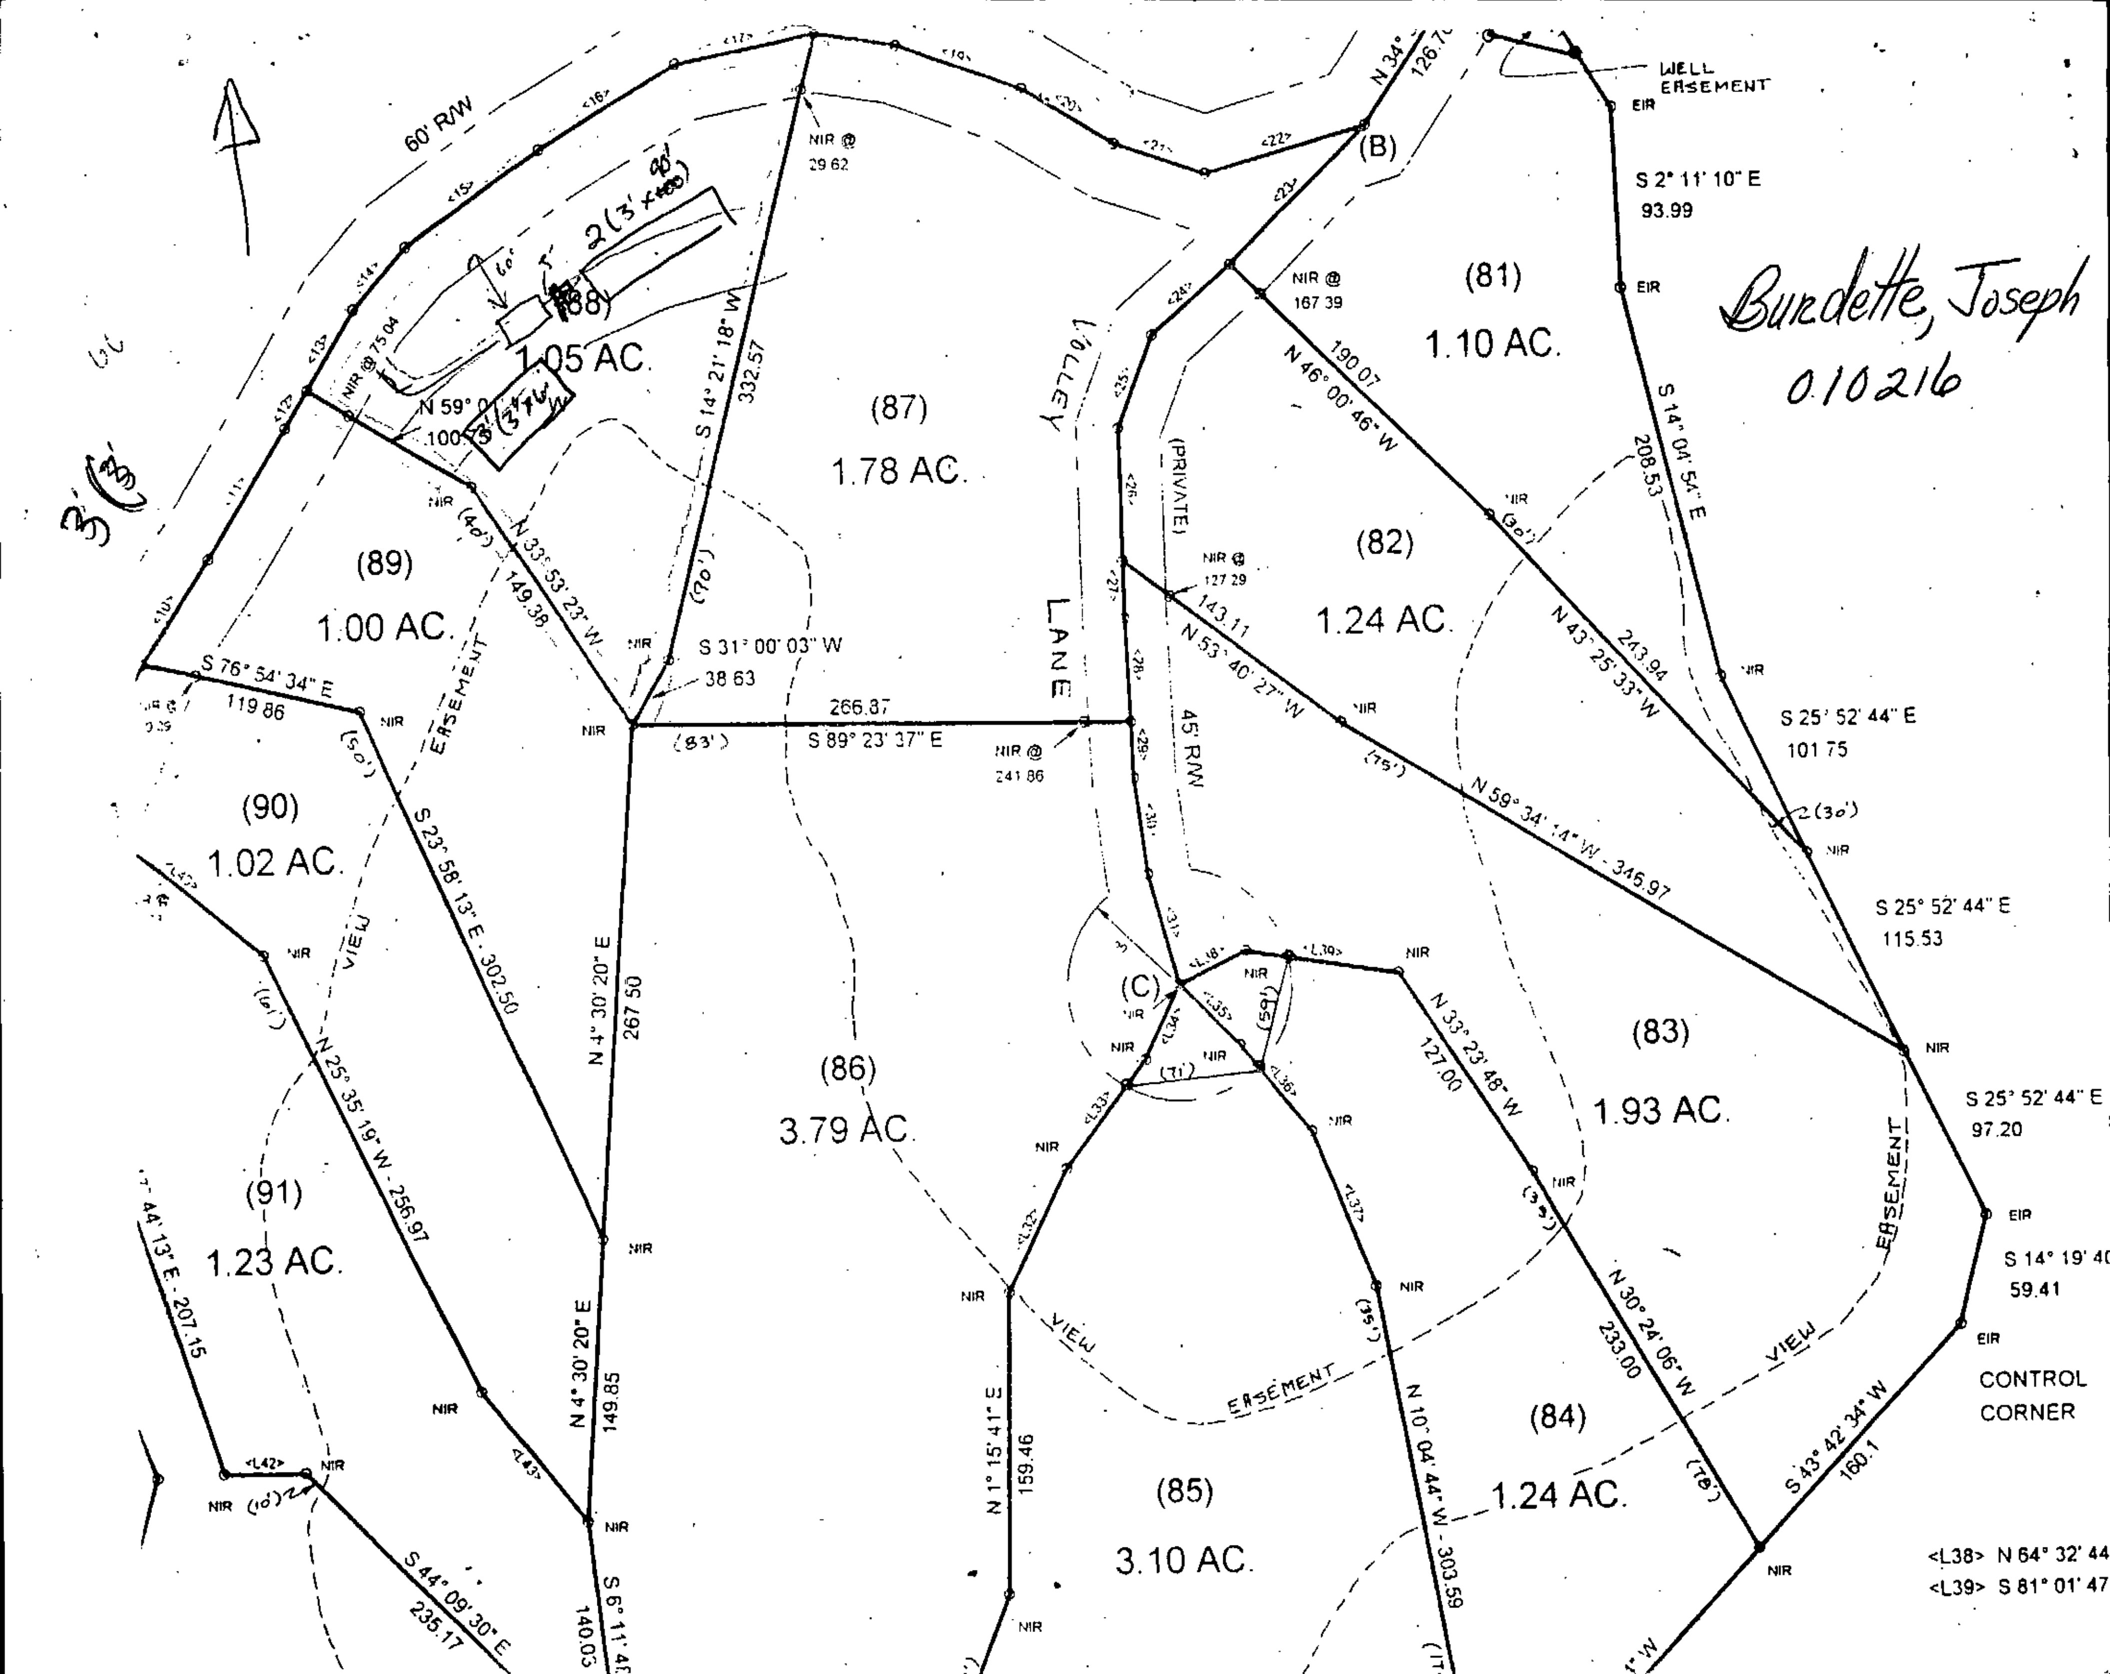

60' R/W
WELL EASEMENT
EIR
(B)
S 2° 11' 10" E
93.99
N 34°
126.7
(81)
1.10 AC.
Burdette, Joseph
010216
(88)
1.05 AC.
NIR @ 29.62
NIR @ 75.04
N 59° 0
100.
(87)
1.78 AC.
S 14° 21' 18" W
332.57
LOLLEY LANE
(PRIVATE)
45' R/W
NIR @ 167.39
190.07
N 46° 00' 46" W
S 14° 04' 54" E
208.53
(82)
1.24 AC.
NIR @ 127.29
143.11
N 53° 40' 27" W
N 43° 25' 33" W
243.94
(89)
1.00 AC.
N 33° 53' 23" W
149.38
S 31° 00' 03" W
38.63
S 76° 54' 34" E
119.86
266.87
S 89° 23' 37" E
NIR @ 241.86
EASEMENT
S 25° 52' 44" E
101.75
(90)
1.02 AC.
S 23° 58' 13" E - 302.50
N 59° 34' 14" W - 346.97
S 25° 52' 44" E
115.53
VIEW
N 4° 30' 20" E
267.50
(C)
N 33° 23' 48" W
127.00
(83)
1.93 AC.
(86)
3.79 AC.
S 25° 52' 44" E
97.20
(91)
1.23 AC.
N 25° 35' 19" W - 256.97
S 14° 19' 40
59.41
N 30° 24' 06" W
233.00
VIEW EASEMENT
CONTROL CORNER
N 1° 15' 41" E
159.46
N 10° 04' 44" W - 303.59
(84)
1.24 AC.
44' 13" E - 207.15
N 4° 30' 20" E
149.85
(85)
3.10 AC.
S 43° 42' 34" W
160.1
S 44° 09' 30" E
235.17
S 6° 11' 45
140.03
<L38> N 64° 32' 44
<L39> S 81° 01' 47
NIR

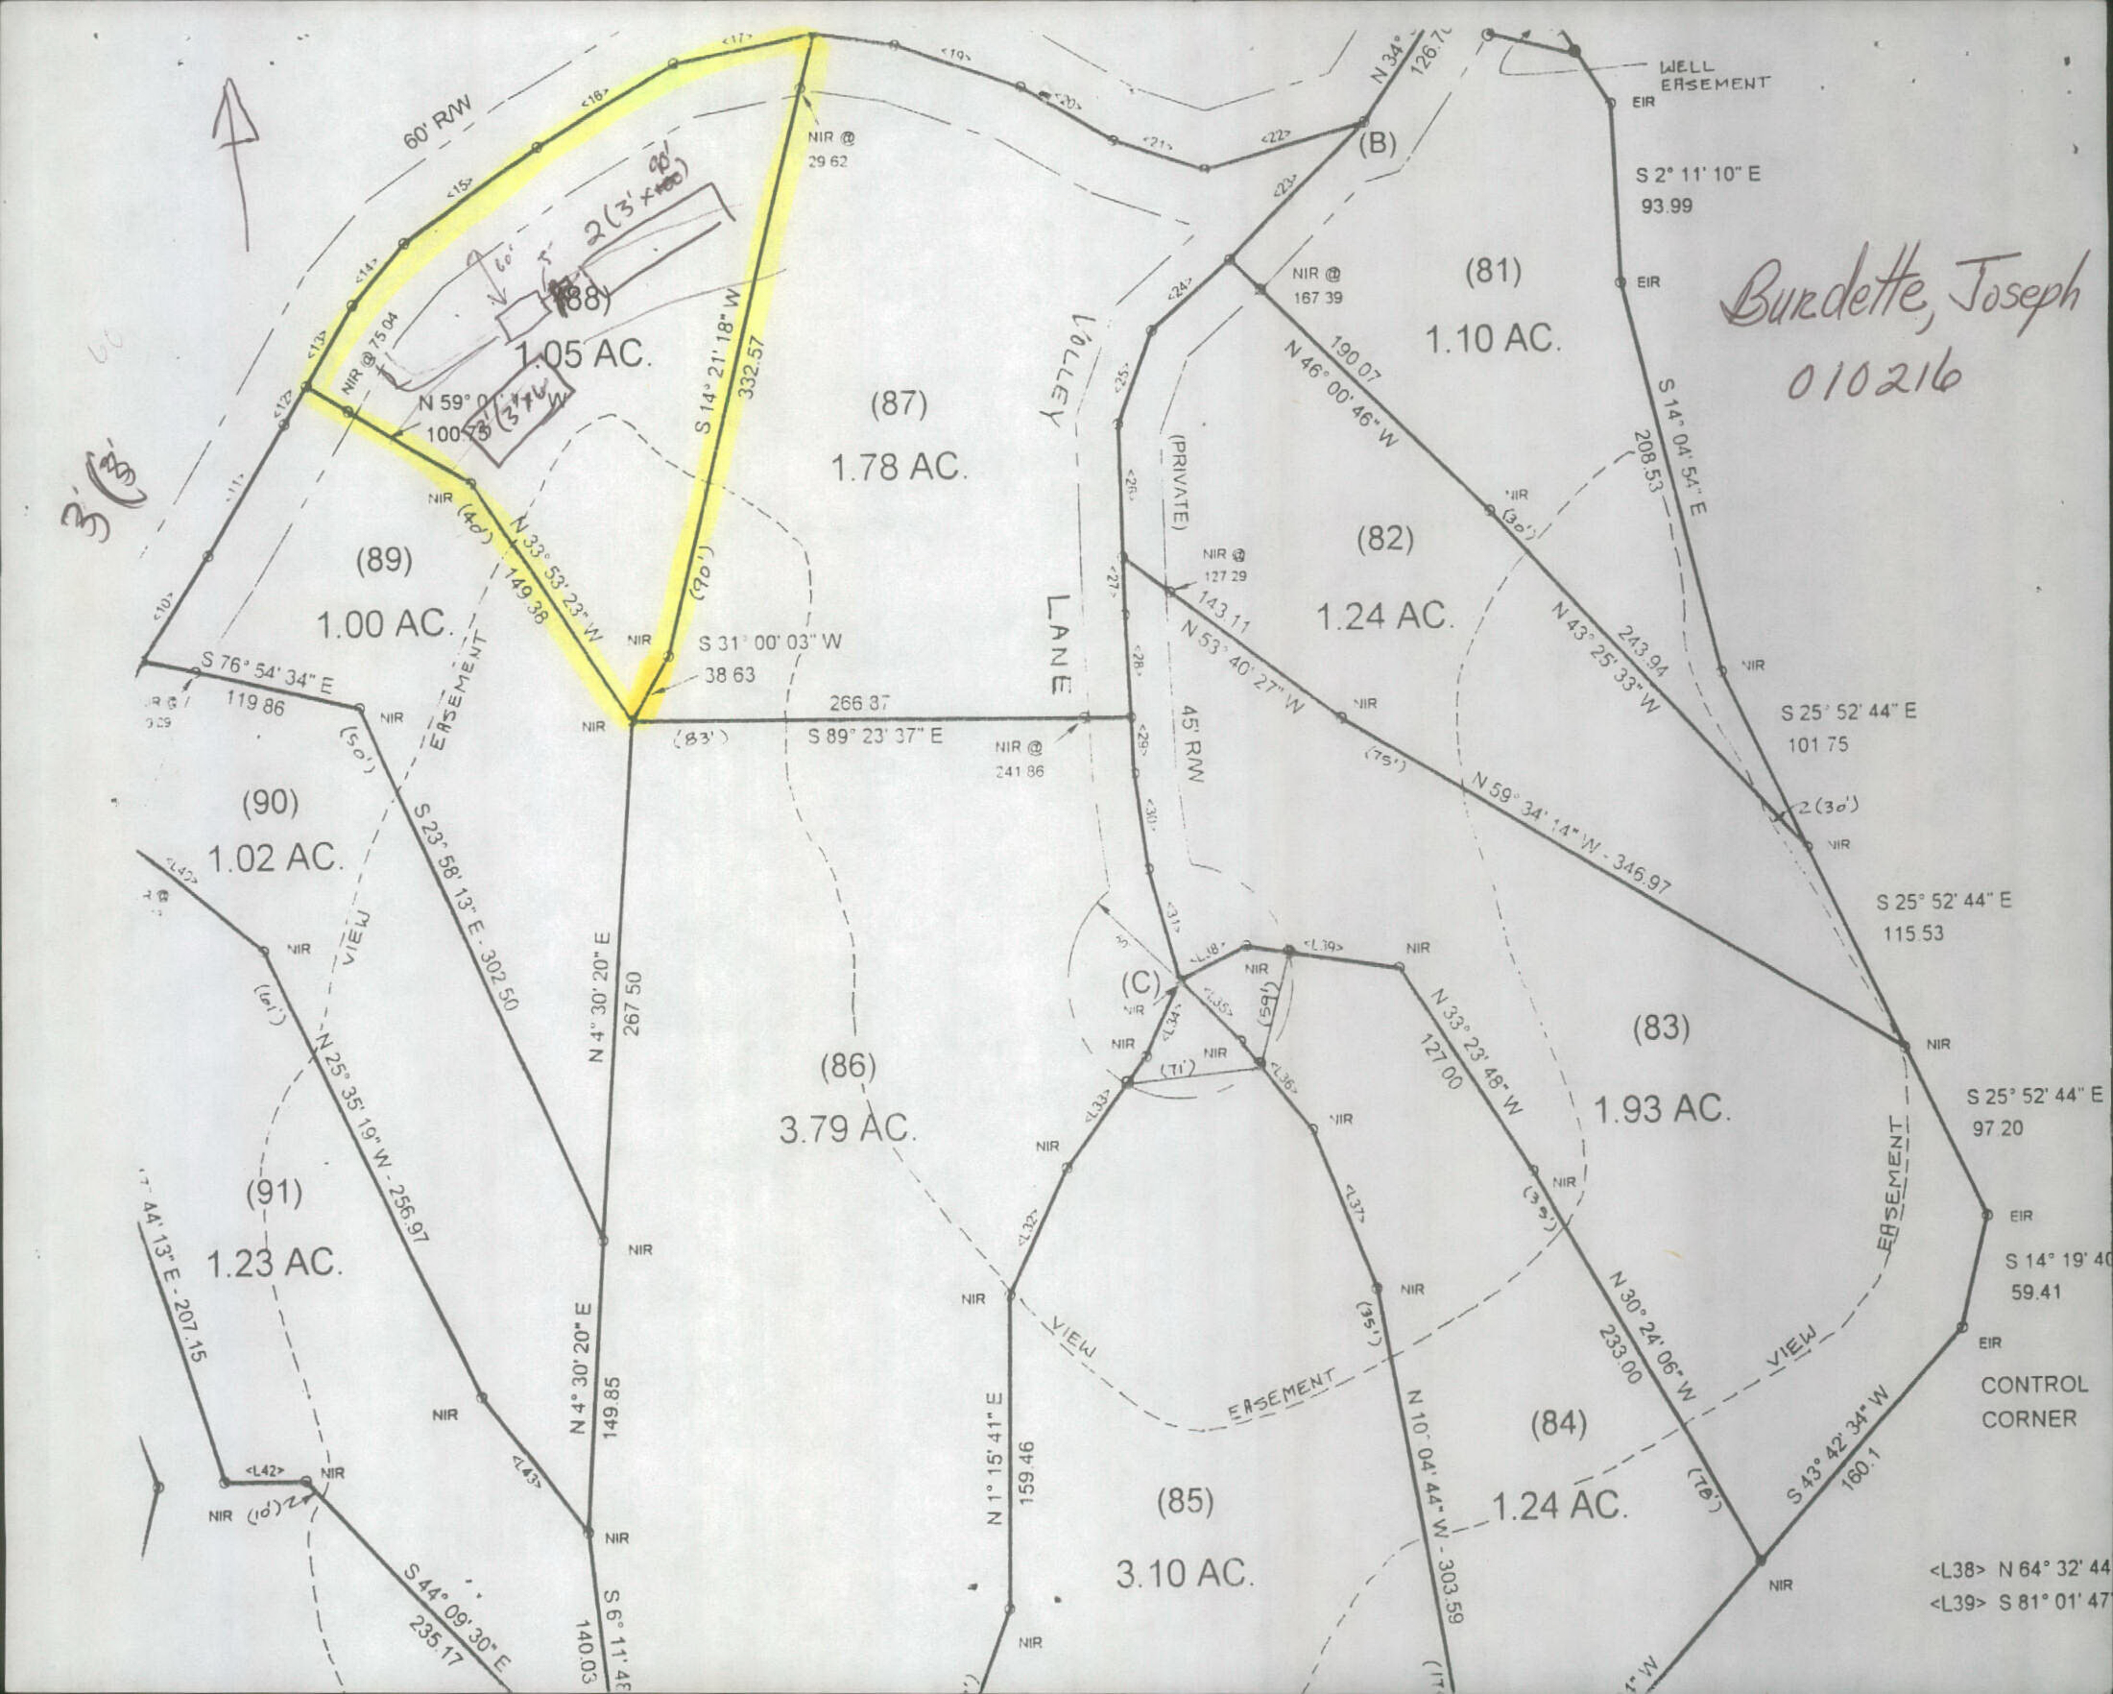

60' R/W
WELL EASEMENT
EIR
NIR @ 29.62
(B)
S 2° 11' 10" E
93.99
(81)
1.10 AC.
Burdette, Joseph
010216
(88)
1.05 AC.
NIR @ 75.04
N 59° 0
100.73
S 14° 21' 18" W
332.57
(87)
1.78 AC.
VOLLEY LANE
(PRIVATE)
NIR @ 167.39
N 46° 00' 46" W
190.07
S 14° 04' 54" E
208.53
(82)
1.24 AC.
NIR @ 127.29
N 53° 40' 27" W
143.11
N 43° 25' 33" W
243.94
(89)
1.00 AC.
N 33° 53' 23" W
149.38
S 31° 00' 03" W
38.63
S 76° 54' 34" E
119.86
EASEMENT
266.87
S 89° 23' 37" E
NIR @ 241.86
45' R/W
S 25° 52' 44" E
101.75
N 59° 34' 14" W - 346.97
(90)
1.02 AC.
S 23° 58' 13" E - 302.50
N 4° 30' 20" E
267.50
S 25° 52' 44" E
115.53
(C)
VIEW
N 25° 35' 19" W - 256.97
(86)
3.79 AC.
N 33° 23' 48" W
127.00
(83)
1.93 AC.
S 25° 52' 44" E
97.20
(91)
1.23 AC.
N 4° 30' 20" E
149.85
N 1° 15' 41" E
159.46
VIEW
EASEMENT
N 30° 24' 06" W
233.00
EASEMENT
VIEW
S 14° 19' 40
59.41
CONTROL CORNER
(84)
1.24 AC.
(85)
3.10 AC.
N 10° 04' 44" W - 303.59
S 43° 42' 34" W
160.1
S 44° 09' 30" E
235.17
140.03
S 6° 11' 48
<L38> N 64° 32' 44
<L39> S 81° 01' 47

ck # 5646
pt # 45196

9/19/01

APPLICATION # 010216

Rutherford-Polk-McDowell District Health Department
Application for Site Evaluation

Owner/Legal Agent: Thomas C. McKay (Land Finders) FOR: Joseph H Burdette

Mailing Address: 1208 Shadow Way (P.O. Box or Street) Greenville (City) S.C. (State) 29615 (Zip) Land Finders

County: Polk Home Phone #: 864 284-2320 Work Phone #: 249-5221

Street/Development Name/Lot # Piney Mtn Ph IV Section II Lot 88

Directions to property - State Road no. and Name: I-26 to Saluda (28) rt on Hollands cove 6 miles to Piney Gate Rd L to end, L on Wesley Lane past 2nd subdiv Rd on L 400 ft to Lot 88 on L

Type of Facility: ☒ House ☐ Mobile Home ☐ Other: _____

Lot Size: 1.05 AC Number of Bedrooms: 3 Number of Occupants: 4

Garbage Disposal: ☐ Yes ☒ No Basement with plumbing: ☐ Yes ☒ No

Type of water supply: ☒ Private ~~well~~ water system ☐ Public or community water system ☐ Spring

BEFORE THE SITE CAN BE EVALUATED, THE FOLLOWING ITEMS MUST BE COMPLETED:

(1) A survey plat of the site must accompany this application showing the following drawn on it: the proposed building (decks, porches, garages included), driveway, water supply, surface waters, easements or rights of way and other pertinent features.

(2) Property lines and house/mobile home corners must be clearly field marked on the site, with furnished ribbons.

(3) Property must be reasonably clear of undergrowth or obstacles that prohibit a thorough site evaluation.

(4) Please display orange Health Department sign furnished in a visible spot at roadside to aid in site location.

(5) Site considerations may be affected by other ordinances, i.e.: flood plain or watershed, zoning, planning board restraints, restricted land use, etc., and the building inspector should be contacted prior to the health department evaluation to see if any ordinances are applicable.

The undersigned person hereby agrees that he/she has read the foregoing application and that the contents of the same are true as submitted. Any alteration of the site or soil conditions, changes to the proposed facility to be served, or submission of false information with this application may subject the improvement permit to suspension or revocation procedures. I understand that this is a formal application for a lot evaluation for a ground absorption sewage disposal system and authorize the Rutherford-Polk-McDowell District Health Department employees to go on this property for evaluation purposes. The application fee is non-refundable should the site evaluation find the site unsuitable.

Owner/Legal Agent Thomas C. McKay Date 09/13/01

LP-700

☒ New
☐ Repair
☐ Addition

APPLICATION # 016224

Rutherford-Polk-McDowell District Health Department
Improvement Permit (Expiration Date) 10-02-06

(Permit subject to revocation if site plans or intended use change)

Owner or Legal Agent: Burdette, Joseph H. County: Polk

Mailing Address:

Street/Develop. Name/Lot # Piney Mtn. S/D Ph. IV; Sect I; Lot 81

Home Phone #: Work Phone #:

Directions to property - State Road No. and Name: From Saluda, Hd. Cove Rd - 6 miles (L) onto Piney Gate Rd. to end. (L) on Wesley Ln. to 2nd S/D rd. on (L) Lot 81 1st on (L)

Type of water supply: ☐ Private well ☒ Public or community water system ☐ Spring

Type of Facility: 3br. home - no basement Type of Wastewater System: III 25% no-gravel mound

Design Waste Flow: 360 G.P.D. L.T.A.R. 0.5 ps Tank Capacity (min.) 1,000 gallons

No. of Trenches 3 Trench Length 60 Ft. Trench Width 3 Ft Max. Trench Depth 24 In.

Conditions/Comments: Maintain all specified setbacks. - Stay 100' from well.

* NOT DRAWN TO SCALE * *SITE PLAN WITH SYSTEM DETAILS* LOT SIZE 1.10 acres

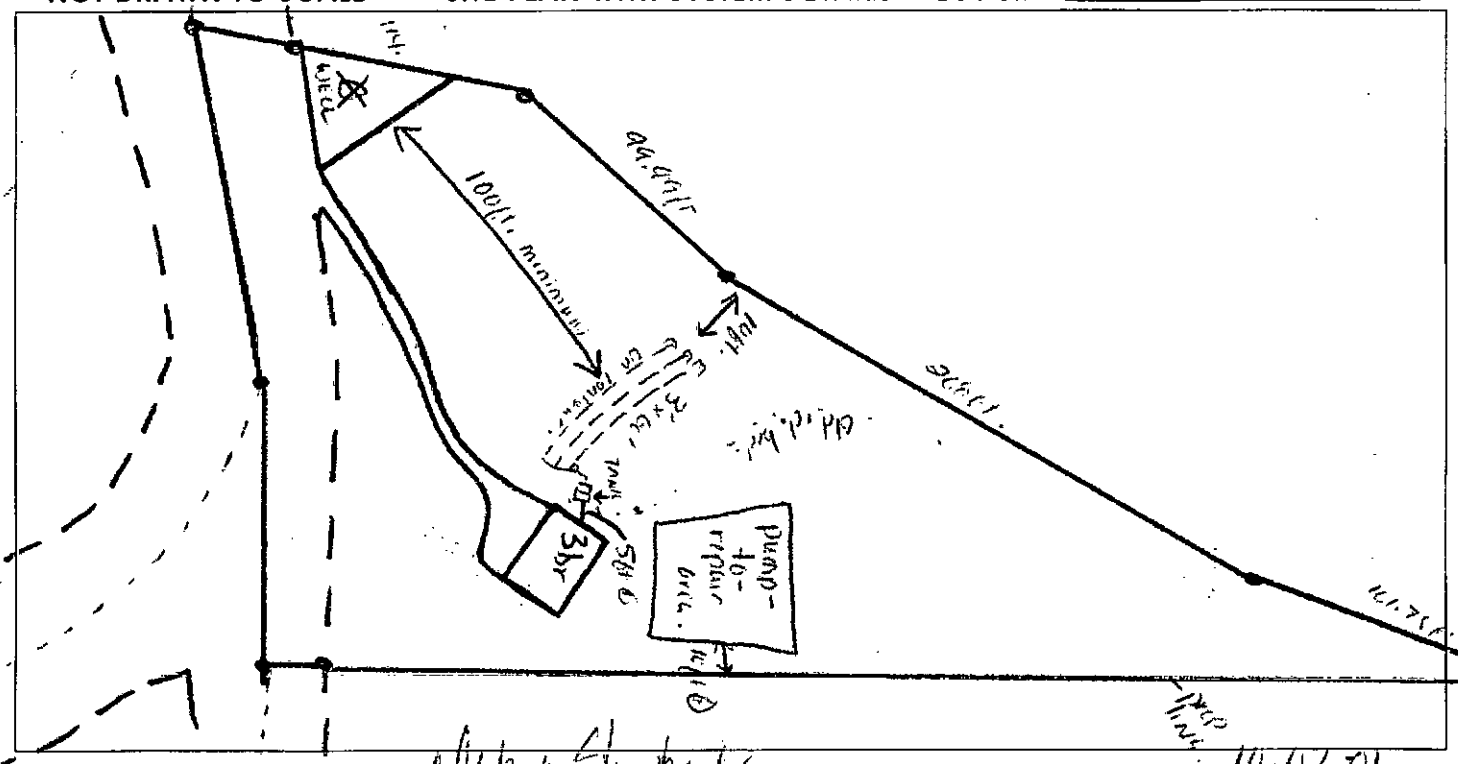

Issued By: Ruth a Shepherd Date: 10-01-01
Environmental Health Specialist

AUTHORIZATION FOR WASTEWATER SYSTEM CONSTRUCTION
(VOID AFTER 5 YEARS)

Construction of the wastewater system for the improvement permit indicated above is hereby authorized. The wastewater system described in the improvement permit has been designed and can be installed and operated in compliance with Article 11 of Chapter 130A of the General Statutes of N. C. and Rules adopted pursuant to this article. Any alteration of the site or soil conditions, changes to the proposed facility to be served, or submission of false information may subject the permit and authorization to suspension or revocation.

Issued By: Ruth a Shepherd Date: 10-02-01
Environmental Health Specialist

LP-513

WHITE - OWNER/AGENT PINK - BLDG. INSPECTOR MANILLA - HEALTH DEPT.

Owner or Legal Agent: Burdette, Joseph H. Piney Mtn. PH IV Sect I Lot 81

ck # 5646
cash # 45196

9/19/01

APPLICATION # 010224

Rutherford-Polk-McDowell District Health Department
Application for Site Evaluation

Owner/Legal Agent: Thomas E. McKay (Land Finders) FOR: Joseph H Burdette

Mailing Address: 1208 Shadow Way (P.O. Box or Street) Greenville (City) S.C. (State) 29615 (Zip)

County: Polk Home Phone #: 864 284-2320 Work Phone #: Land Finders 249-5221

Street/Development Name/Lot # Piney Mtn Ph IV Section II Lot 81

Directions to property - State Road no. and Name: I-26 to Saluda (28) rt on Hollands Cour
Go 1 mile to Piney Gate Rd L to end, L on Wesley Lane to 2nd Subdiv on L
Lot 81 is at start of Rd on L

Type of Facility: ☒ House ☐ Mobile Home ☐ Other: _____

Lot Size: 1.1 AC Number of Bedrooms: 3 Number of Occupants: 4

Garbage Disposal: ☐ Yes ☒ No Basement with plumbing: ☐ Yes ☒ No

Type of water supply: ☒ Private ~~well~~ water system ☐ Public or community water system ☐ Spring

BEFORE THE SITE CAN BE EVALUATED, THE FOLLOWING ITEMS MUST BE COMPLETED:

(1) A survey plat of the site must accompany this application showing the following drawn on it: the proposed building (decks, porches, garages included), driveway, water supply, surface waters, easements or rights of way and other pertinent features.

(2) Property lines and house/mobile home corners must be clearly field marked on the site, with furnished ribbons.

(3) Property must be reasonably clear of undergrowth or obstacles that prohibit a thorough site evaluation.

(4) Please display orange Health Department sign furnished in a visible spot at roadside to aid in site location.

(5) Site considerations may be affected by other ordinances, i.e.: flood plain or watershed, zoning, planning board restraints, restricted land use, etc., and the building inspector should be contacted prior to the health department evaluation to see if any ordinances are applicable.

The undersigned person hereby agrees that he/she has read the foregoing application and that the contents of the same are true as submitted. Any alteration of the site or soil conditions, changes to the proposed facility to be served, or submission of false information with this application may subject the improvement permit to suspension or revocation procedures. I understand that this is a formal application for a lot evaluation for a ground absorption sewage disposal system and authorize the Rutherford-Polk-McDowell District Health Department employees to go on this property for evaluation purposes. The application fee is non-refundable should the site evaluation find the site unsuitable.

Owner/Legal Agent Thomas E. McKay Date 09/13/01

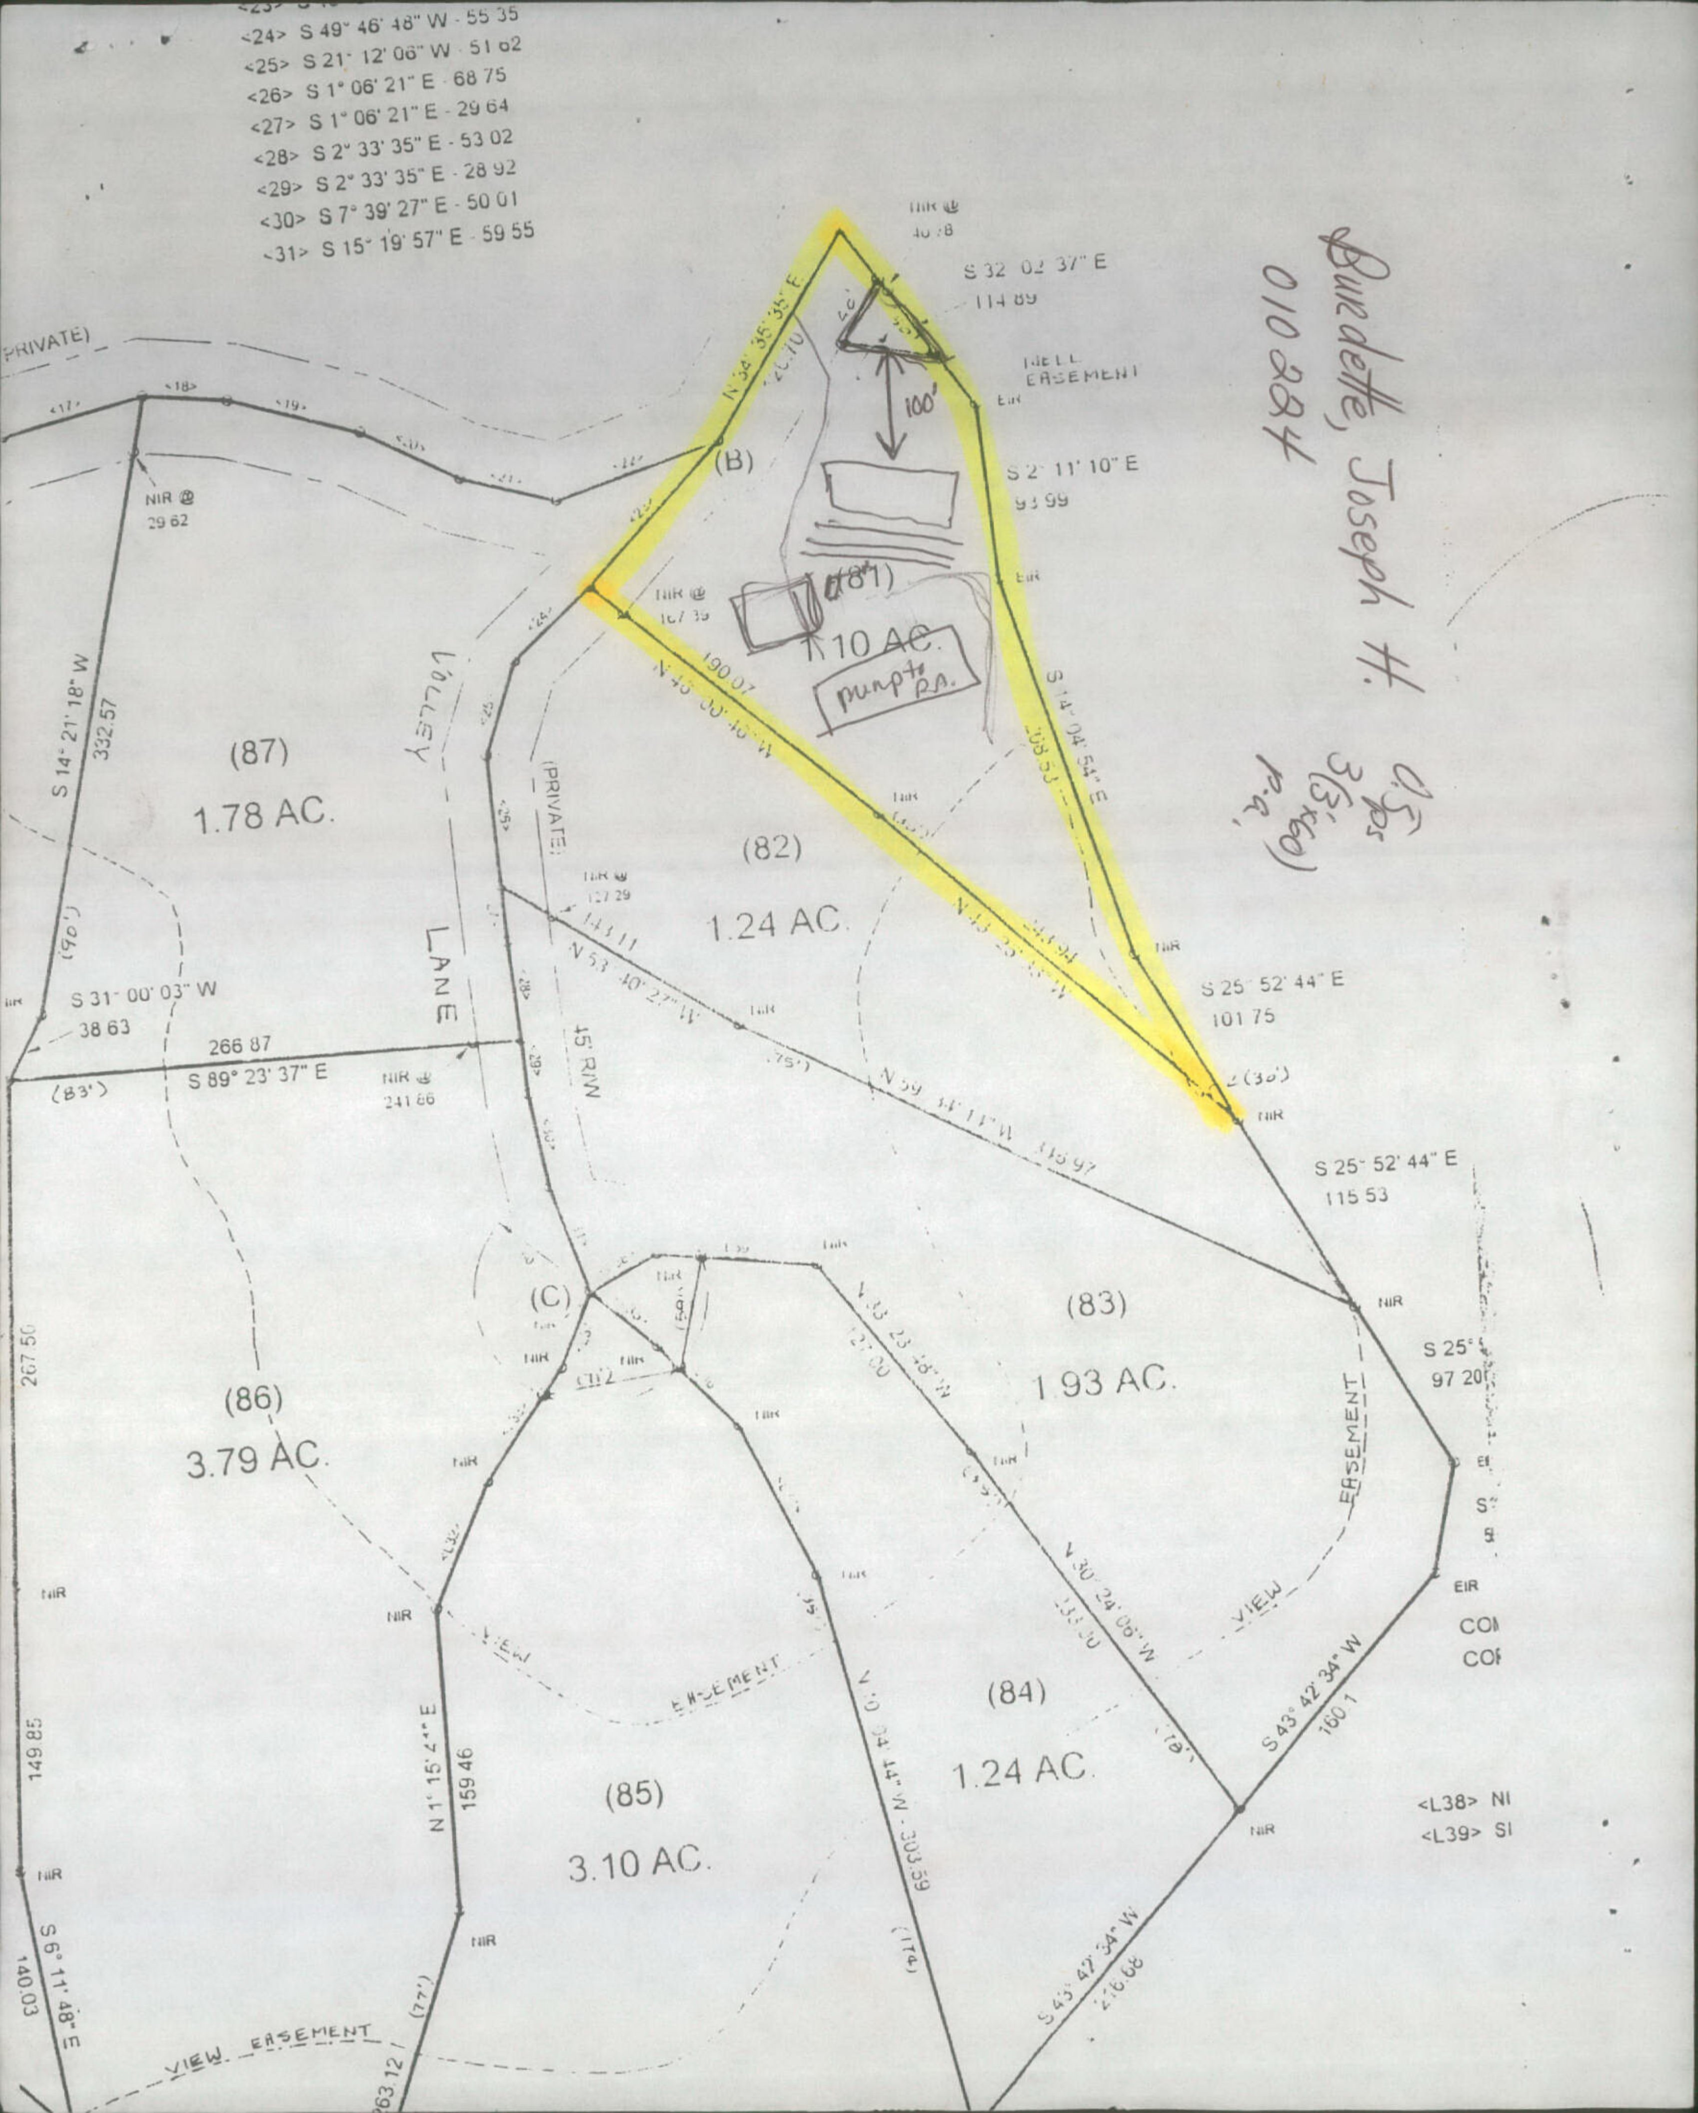

<24> S 49° 46' 48" W - 55 35
<25> S 21° 12' 06" W - 51 62
<26> S 1° 06' 21" E - 68 75
<27> S 1° 06' 21" E - 29 64
<28> S 2° 33' 35" E - 53 02
<29> S 2° 33' 35" E - 28 92
<30> S 7° 39' 27" E - 50 01
<31> S 15° 19' 57" E - 59 55
Burdette, Joseph H.
010 284
0.5 ps
3 (3' x 60)
p.a.
(PRIVATE)
S 32 02 37" E
114 89
WELL EASEMENT
100'
(B)
S 2° 11' 10" E
93 99
NIR
29 62
(81)
1.10 AC.
pump to P.A.
190 07
S 14° 21' 18" W
332.57
(87)
1.78 AC.
VALLEY LANE
(PRIVATE)
(82)
1.24 AC.
143 11
N 53° 40' 27" W
S 25° 52' 44" E
101 75
S 31° 00' 03" W
38 63
266 87
S 89° 23' 37" E
NIR
241 86
45' R/W
N 59° 41' 11" W
S 25° 52' 44" E
115 53
(C)
(83)
1.93 AC.
267 50
(86)
3.79 AC.
EASEMENT
S 25°
97 20
VIEW
VIEW
EASEMENT
N 30° 24' 06" W
S 43° 42' 34" W
160 1
(84)
1.24 AC.
N 1° 15' 4" E
159 46
(85)
3.10 AC.
N 10° 04' 44" W - 303.59
149 85
<L38> NI
<L39> SI
S 6° 11' 48" E
140.03
S 43° 42' 34" W
216.68
VIEW EASEMENT