TRANSYLVANIA COUNTY HEALTH DEPARTMENT

(Sewage disposal system) Improvements Permit and Certificate of Completion

(Ground Absorption Sewage Disposal System - Section 130 - 160 of Chapter 130 of the General Statutes of North Carolina)

OWNER-OCCUPANT Richard Kantner BUILDING CONTRACTOR Bichard Plumbing

LOCATION Rt 2 Rosman Forest

SUBDIVISION Knob Creek LOT NO. 46 SECT. OR BLOCK NO. 3

SEPTIC TANK CONTRACTOR Allison Ditching ADDRESS

HOUSE [X] MOBILE HOME [ ] BUSINESS [ ]

NO. BEDROOMS 3 NO. BATHROOMS 2

SIZE OF SEPTIC TANK 860 GALS. (Liquid)

MATERIAL: PRE-CAST [X] BLOCK [ ] FIBERGLASS [ ]

DISTRIBUTION BOX YES [ ] NO [ ]

NO. OF LINES 2 WIDTH 3 FT. LENGTH 100 FT.

PERCOLATION TEST YES [ ] NO [X]

WATER SUPPLY: INDIVIDUAL [ ] PUBLIC [X]

SITE CLASSIFICATION: SUITABLE [ ]
PROV. SUITABLE [X]
UNSUITABLE [ ]

IMPROVEMENTS PERMIT: DATE: 11-9-77
BY Harold C. McDowell R.S.

CERTIFICATE OF COMPLETION: DATE: 12-21-77
BY Harold McDowell, RS

NOTICE: System installed according to Rules and Regulations but not a guarantee that it will function satisfactorily for any given period of time.

COLOR CODE: White-Owner; Pink-Improvements Permit; Blue - Contractor; Green - Health Dept.

IMPROVEMENTS PERMIT SKETCH

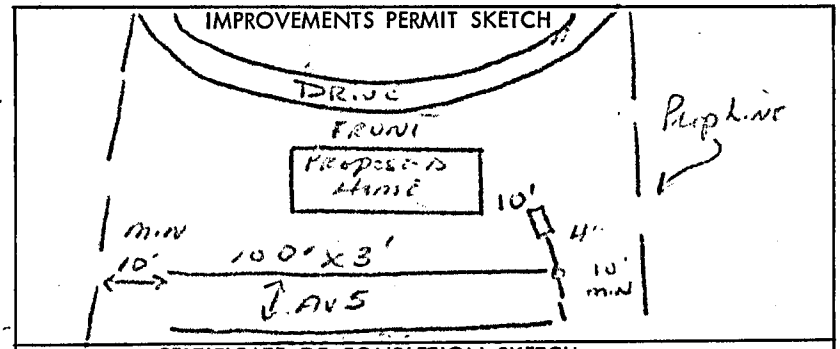

CERTIFICATE OF COMPLETION SKETCH